

CARD MUST BE TYPED

State of Kansas

CARD MUST BE SIGNED

# NOTICE OF INTENTION TO DRILL

(see rules on reverse side)

Expected Spud Date..... 11 month 12 day 1988 year

API Number 15-107-23,023-00-00 ✓ DA

OPERATOR: License # 5872  
Name THOMAS MOYLAN  
Address RR #2 Box 48  
City/State/Zip LaCygne, Kansas 66040  
Contact Person Thomas Moylan  
Phone (913) 757-4426

APF NE SW SW Sec. 12 Twp. 20 S, Rg. 23  East  West  
1165 Ft. from South Line of Section  
4520 Ft. from East Line of Section

(Note: Locate well on Section Plat on reverse side)

CONTRACTOR: License #  
Name COMPANY TOOLS  
City/State

Nearest lease or unit boundary line ..... 720 feet  
County LINN  
Lease Name STAINBROOK Well # G-1

Well Drilled For: Well Class: Type Equipment:  
 Oil  Storage  Infield  Mud Rotary  
 Gas  Inj  Pool Ext.  Air Rotary  
 OWWO  Expl  Wildcat  Cable

Ground surface elevation ..... feet MSL  
Domestic well within 330 feet:  yes  no  
Municipal well within one mile:  yes  no  
Depth to bottom of fresh water ..... 60  
Depth to bottom of usable water ..... 200

If OWWO: old well info as follows:  
Operator  
Well Name  
Comp Date Old Total Depth

Surface pipe by Alternate: 1  2   
Surface pipe planned to be set ..... 40  
Conductor pipe required ..... 0  
Projected Total Depth ..... 480 feet  
Formation Squirrel

I certify that well will comply with K.S.A. 55-101, et seq., plus eventually plugging hole to KCC specifications.  
Date 11-7-88 Signature of Operator or Agent [Signature] Title Agent

For KCC Use:  
Conductor Pipe Required ..... feet; Minimum Surface Pipe Required 20' feet per Alt. K (2)  
This Authorization Expires 5-7-89 Approved By LKM 11-7-88


EFFECTIVE DATE: 11-12-88

Must be filed with the K.C.C. five (5) days prior to commencing well  
This card void if drilling not started within six (6) months of date received by K.C.C.

### Important procedures to follow:

1. Notify District office before setting surface casing.
2. Set surface casing by circulating cement to the top.
3. File completion forms ACO-1 with K.C.C. within 120 days of well spud date, following instructions on ACO-1, side 1, and including copies of wireline logs.
4. Notify District office 48 hours prior to old well workover or re-entry.
5. Prior to filing Intent, prepare a proposed plugging plan in case well is D & A, then obtain approval of plan when calling district office prior to setting surface pipe.
6. Submit plugging report (CP-4) to K.C.C. after plugging is completed.
7. Obtain an approved injection docket number before disposing of salt water.
8. Notify K.C.C. within 10 days when injection commences or terminates.

### A Regular Section of Land 1 Mile = 5,280 Ft.

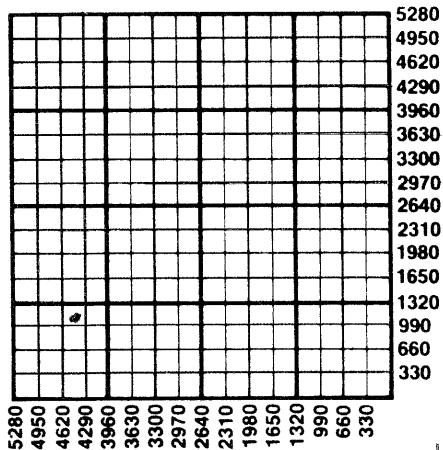

RECEIVED  
STATE CORPORATION COMMISSION  
RATIO

NOV 7 1988

CONSERVATION DIVISION  
Wichita, Kansas

11-7-88

alternate 2 completion, cement in the production pipe from below any usable water to surface within 120 days of spud date.

State Corporation Commission of Kansas  
Conservation Division  
200 Colorado Derby Building  
Wichita, Kansas 67202-1212  
(316) 263-3238