

CORRECTED  
7-27-07

\* CORRECTED \*

RECEIVED

For KCC Use:  
Effective Date: 3-13-07  
District # 1  
SGA?  Yes  No

KANSAS CORPORATION COMMISSION  
OIL & GAS CONSERVATION DIVISION

MAR 07 2007

Form C-1  
November 2005  
Form must be Typed  
Form must be Signed  
All blanks must be Filled

NOTICE OF INTENT TO DRILL

Must be approved by KCC five (5) days prior to commencing

CONSERVATION DIVISION  
WICHITA, KS

Expected Spud Date: 03/15/2007  
month day year

Spot Description:  
30'S & 150'E, S2 NE Sec. 34 Twp. 33 S. R. 11  E  W  
(~~1980~~) ~~2010~~ FNL feet from  N /  S Line of Section  
1320 ~~1170~~ FEL feet from  E /  W Line of Section

OPERATOR: License# 33168  
Name: Woolsey Operating Company, LLC  
Address 1: 125 N. Market, Suite 1000  
Address 2:  
City: Wichita State: KS Zip: 67202 + 1775  
Contact Person: Dean Pattison  
Phone: 316-267-4379  
CONTRACTOR: License# 5929  
Name: Duke Drilling Co., Inc.

Is SECTION:  Regular  Irregular?  
(Note: Locate well on the Section Plat on reverse side)

County: Barber  
Lease Name: FORESTER 'A' Well #: 3  
Field Name: ROUNDUP SOUTH

Is this a Prorated / Spaced Field?  Yes  No  
Target Formation(s): MISSISSIPPIAN  
Nearest Lease or unit boundary line (in footage): 1320

Well Drilled For:  Oil  Enh Rec  Gas  Storage  Disposal  Seismic; # of Holes  Other:  
Well Class:  Infield  Pool Ext.  Wildcat  Other  
Type Equipment:  Mud Rotary  Air Rotary  Cable

Ground Surface Elevation: 1390 feet MSL  
Water well within one-quarter mile:  Yes  No  
Public water supply well within one mile:  Yes  No

Depth to bottom of fresh water: 150  
Depth to bottom of usable water: 180  
Surface Pipe by Alternate:  I  II

Length of Surface Pipe Planned to be set: 250  
Length of Conductor Pipe (if any): 0  
Projected Total Depth: 5150  
Formation at Total Depth: SIMPSON

Water Source for Drilling Operations:  
 Well  Farm Pond  Other: TO BE HAULED  
DWR Permit #: \_\_\_\_\_

(Note: Apply for Permit with DWR )  
Will Cores be taken?  Yes  No  
If Yes, proposed zone: \_\_\_\_\_

Directional, Deviated or Horizontal wellbore?  Yes  No  
If Yes, true vertical depth: \_\_\_\_\_  
Bottom Hole Location: \_\_\_\_\_  
KCC DKT #: \_\_\_\_\_

was 1980' FNL; is 2010' FNL  
was 1320' FEL; is 1170' FEL  
was S2 NE; is 30'S&150'E of S2 NE

AFFIDAVIT

The undersigned hereby affirms that the drilling, completion and eventual plugging of this well will comply with K.S.A. 55 et. seq.  
It is agreed that the following minimum requirements will be met:

1. Notify the appropriate district office **prior** to spudding of well;
2. A copy of the approved notice of intent to drill **shall be** posted on each drilling rig;
3. The minimum amount of surface pipe as specified below **shall be set** by circulating cement to the top; in all cases surface pipe **shall be set** through all unconsolidated materials plus a minimum of 20 feet into the underlying formation.
4. If the well is dry hole, an agreement between the operator and the district office on plug length and placement is necessary **prior to plugging**;
5. The appropriate district office will be notified before well is either plugged or production casing is cemented in;
6. If an ALTERNATE II COMPLETION, production pipe shall be cemented from below any usable water to surface within **120 DAYS** of spud date.  
Or pursuant to Appendix "B" - Eastern Kansas surface casing order #133,891-C, which applies to the KCC District 3 area, alternate II cementing must be completed within 30 days of the spud date or the well shall be plugged. **In all cases, NOTIFY district office** prior to any cementing.

I hereby certify that the statements made herein are true and to the best of my knowledge and belief.

Date: 03/07/07 Signature of Operator or Agent: Dean Pattison Title: Operations Manager

For KCC Use ONLY  
API # 15 - 007-23126-0000  
Conductor pipe required None feet  
Minimum surface pipe required 200 feet per ALT.  I  II  
Approved by: 3-8-07 3-8-07  
This authorization expires: 9-8-07  
(This authorization void if drilling not started within 6 months of approval date.)  
Spud date: \_\_\_\_\_ Agent: \_\_\_\_\_

Remember to:

- File Drill Pit Application (form CDP-1) with Intent to Drill;
- File Completion Form ACO-1 within 120 days of spud date;
- File acreage attribution plat according to field proration orders;
- Notify appropriate district office 48 hours prior to workover or re-entry;
- Submit plugging report (CP-4) after plugging is completed (within 60 days);
- Obtain written approval before disposing or injecting salt water.
- If this permit has expired (See: authorized expiration date) please check the box below and return to the address below.

Well Not Drilled - Permit Expired Date: \_\_\_\_\_  
Signature of Operator or Agent: \_\_\_\_\_

Mail to: KCC - Conservation Division, 130 S. Market - Room 2078, Wichita, Kansas 67202

RECEIVED  
KANSAS CORPORATION COMMISSION  
JUL 27 2007  
CONSERVATION DIVISION  
WICHITA, KS

34  
33  
11  
 m  
 w

CORRECTED

**IN ALL CASES PLOT THE INTENDED WELL ON THE PLAT BELOW**

*Plat of acreage attributable to a well in a prorated or spaced field*

If the intended well is in a prorated or spaced field, please fully complete this side of the form. If the intended well is in a prorated or spaced field complete the plat below showing that the well will be properly located in relationship to other wells producing from the common source of supply. Please show all the wells and within 1 mile of the boundaries of the proposed acreage attribution unit for gas wells and within 1/2 mile of the boundaries of the proposed acreage attribution unit for oil wells.

API No. 15 - 007-23126-0000  
Operator: Woolsey Operating Company, LLC  
Lease: FORESTER 'A'  
Well Number: 3  
Field: ROUNDUP SOUTH

Location of Well: County: Barber  
1980 \*2010' FNL feet from  N /  S Line of Section  
1320 \*1170' FEL feet from  E /  W Line of Section  
Sec. 34 Twp. 33 S. R. 11  E  W

Number of Acres attributable to well: \_\_\_\_\_  
QTR/QTR/QTR/QTR of acreage: \_\_\_\_\_ - S2 - NE

Is Section:  Regular or  Irregular



If Section is Irregular, locate well from nearest corner boundary.

Section corner used:  NE  NW  SE  SW

**PLAT**

*(Show location of the well and shade attributable acreage for prorated or spaced wells.)*

*(Show footage to the nearest lease or unit boundary line.)*

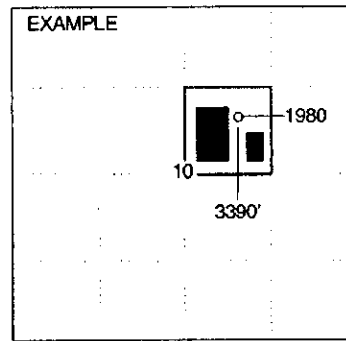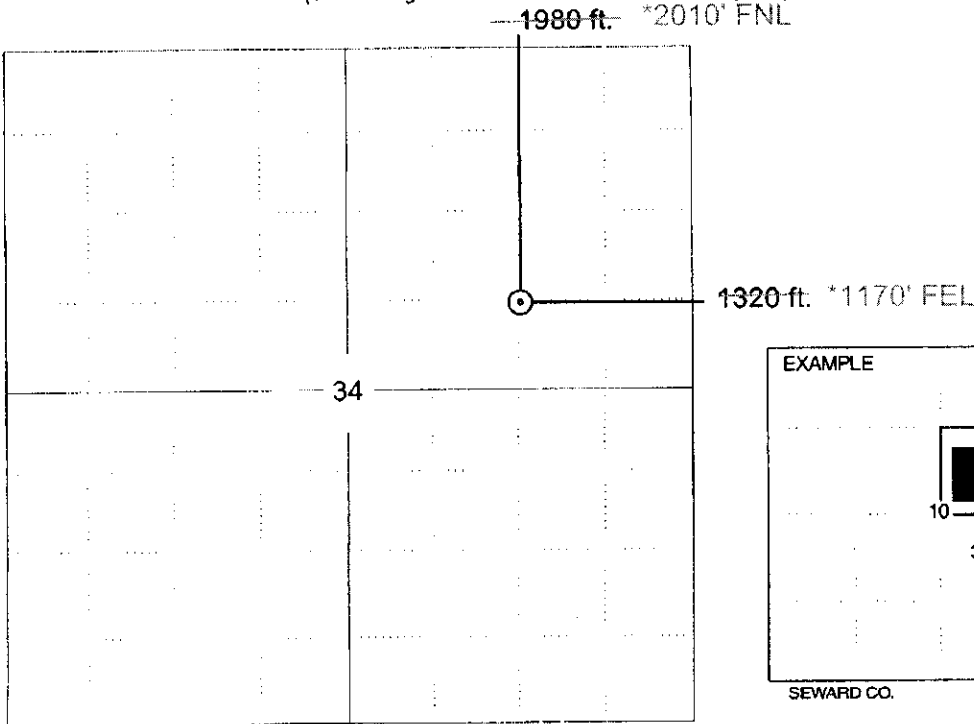

SEWARD CO.

**NOTE: In all cases locate the spot of the proposed drilling location.**

**In plotting the proposed location of the well, you must show:**

1. The manner in which you are using the depicted plat by identifying section lines, i.e. 1 section, 1 section with 8 surrounding sections, 4 sections, etc.
2. The distance of the proposed drilling location from the south / north and east / west outside section lines.
3. The distance to the nearest lease or unit boundary line (in footage).
4. If proposed location is located within a prorated or spaced field a certificate of acreage attribution plat must be attached: (CO-7 for oil wells, CG-8 for gas wells).

RECEIVED  
KANSAS CORPORATION COMMISSION


JUL 27 2007

CONSERVATION DIVISION  
MICHIGAN KS

**KANSAS CORPORATION COMMISSION  
OIL & GAS CONSERVATION DIVISION  
APPLICATION FOR SURFACE PIT**

Form CDP-1  
April 2004  
Form must be Typed

*Submit in Duplicate*

Operator Name: <b>Woolsey Operating Company, LLC</b>		License Number: <b>33168</b>
Operator Address: <b>125 N. Market, Suite 1000</b>		<b>Wichita KS 67202</b>
Contact Person: <b>Dean Pattison</b>		Phone Number: <b>316-267-4379</b>
Lease Name & Well No.: <b>FORESTER 'A' 3</b>		Pit Location (QQQQ): _____ S2 NE
Type of Pit: <input type="checkbox"/> Emergency Pit <input type="checkbox"/> Burn Pit <input type="checkbox"/> Settling Pit <input checked="" type="checkbox"/> Drilling Pit <input type="checkbox"/> Workover Pit <input type="checkbox"/> Haul-Off Pit <small>(If WP Supply API No. or Year Drilled)</small>	Pit is: <input checked="" type="checkbox"/> Proposed <input type="checkbox"/> Existing If Existing, date constructed: _____ Pit capacity: _____ (bbls)	Sec. <b>34</b> Twp. <b>33</b> R. <b>11</b> <input type="checkbox"/> East <input checked="" type="checkbox"/> West * <b>2010' FNL</b> Feet from <input checked="" type="checkbox"/> North / <input type="checkbox"/> South Line of Section * <b>1170' FEL</b> Feet from <input checked="" type="checkbox"/> East / <input type="checkbox"/> West Line of Section <b>Barber</b> County
Is the pit located in a Sensitive Ground Water Area? <input checked="" type="checkbox"/> Yes <input type="checkbox"/> No		Chloride concentration: _____ mg/l <small>(For Emergency Pits and Settling Pits only)</small>
Is the bottom below ground level? <input type="checkbox"/> Yes <input type="checkbox"/> No	Artificial Liner? <input type="checkbox"/> Yes <input type="checkbox"/> No	How is the pit lined if a plastic liner is not used? <b>CLAYS FROM MUD WILL PROVIDE SEALER.</b>
Pit dimensions (all but working pits): <u>80</u> Length (feet) <u>80</u> Width (feet) <input type="checkbox"/> N/A: Steel Pits Depth from ground level to deepest point: <u>4</u> (feet) <input type="checkbox"/> No Pit		
If the pit is lined give a brief description of the liner material, thickness and installation procedure.		Describe procedures for periodic maintenance and determining liner integrity, including any special monitoring. <b>MONITOR PITS UNTIL DRY</b>
Distance to nearest water well within one-mile of pit <u>4602</u> feet    Depth of water well <u>34</u> feet		Depth to shallowest fresh water <u>6</u> feet. <span style="border: 1px solid black; border-radius: 50%; padding: 2px;">10</span> Source of Information: <input type="checkbox"/> measured <input type="checkbox"/> well owner <input type="checkbox"/> electric log <input type="checkbox"/> KDWR
<b>Emergency, Settling and Burn Pits ONLY:</b> Producing Formation: _____ Number of producing wells on lease: _____ Barrels of fluid produced daily: _____ Does the slope from the tank battery allow all spilled fluids to flow into the pit? <input type="checkbox"/> Yes <input type="checkbox"/> No		<b>Drilling, Workover and Haul-Off Pits ONLY:</b> Type of material utilized in drilling/workover: _____ Number of working pits to be utilized: <u>3</u> Abandonment procedure: <b>WHEN DRY, BACKFILL AND RESTORE LOCATION</b> Drill pits must be closed within 365 days of spud date.
I hereby certify that the above statements are true and correct to the best of my knowledge and belief.		
<u>03/07/07</u> Date	 Signature of Applicant or Agent	
<b>KCC OFFICE USE ONLY</b>		
Date Received: <u>3/7/07</u> Permit Number: _____ Permit Date: <u>3/8/07</u> Lease Inspection: <input checked="" type="checkbox"/> Yes <input type="checkbox"/> No	RFAC <input checked="" type="checkbox"/> RFAS <input checked="" type="checkbox"/> <i>OUT DRAW</i>	

CORRECTED

15-007-23126-0000

Mail to: KCC - Conservation Division, 130 S. Market - Room 2078, Wichita, Kansas 67202

RECEIVED  
KANSAS CORPORATION COMMISSION

**JUL 27 2007**

CONSERVATION DIVISION  
WICHITA, KS