Kansas Corporation Commission Oil & Gas Conservation Division

Form ACO-1 September 1999 Form Must Be Typed

WELL COMPLETION FORM WELL HISTORY - DESCRIPTION OF WELL & LEASE


ORIGINAL

Operator: License # 5214	API No. 15 - 095-01551-00-02					
Name: Lario Oil & Gas Company	County: Kingman					
Address: 301 S. Market Street	sw_ne_se_sec. 13 Twp. 28 s. R. 6 East West					
City/State/Zip: Wichita, KS 67207	1650 / Lot 2 feet from S/ N (circle one) Line of Section					
Purchaser: Plains Marketing / EOV Gathering	990°)/97 feet from E W (circle one) Line of Section					
Operator Contact Person: Jay G. Schweikert	Footages Calculated from Nearest Outside Section Corner:					
Phone: (316) 265-5611	(circle one) NE (SE) NW SW					
Contractor: Name: Plains, Inc. (well service)	Lease Name: Clouse Well #: 4 RE/SWD					
License: 4072	Field Name: Hendrick					
Wellsite Geologist:	Producing Formation: Mississippian					
Designate Type of Completion:	Elevation: Ground: 1448 Kelly Bushing: 1453					
New Well Re-Entry Workover	Total Depth: 4560 Plug Back Total Depth: 4521					
Oil SWD SIOW Temp. Abd.	existing Amount of Surface Pipe Set and Cemented at 292 Feet					
✓ Gas ENHR SIGW	Multiple Stage Cementing Collar Used?					
	If yes, show depth setFeet					
Dry Other (Core, WSW, Expl., Cathodic, etc)	If Alternate II completion, cement circulated from					
If Workover/Re-entry: Old Well Info as follows: Operator: Lario Oil & Gas Co.	feet depth to					
Well Name: Clouse #4	leet depth to					
Original Comp. Date: 10/08/58 Original Total Depth: 3969	Drilling Fluid Management Plan (Data must be collected from the Reserve Pit) AUTION S-21-07					
	(Data must be collected from the Reserve Pit)					
Deepening Re-perf. Conv. to Enhr./SWD	Chloride content ppm Fluid volume bbls					
Plug Back Total Depth	Dewatering method used					
Commingled Docket No	Location of fluid disposal if hauled offsite:					
Dual Completion Docket No	Operator Name: RECEIVED					
Other (SWD or Enhr.?) Docket No. D-28313						
03/10/05 03/29/05	Lease Name: Ligens No.: 9 2005 Quarter Sec: Twp. S. R. East West					
Spud Date or Pate Reached TD Completion Date or Recompletion Date Completion Date or Recompletion Date	County: Dock GC WICHITA					
•	Sound.					
Kansas 67202, within 120 days of the spud date, recompletion, workove Information of side two of this form will be held confidential for a period of 1	the Kansas Corporation Commission, 130 S. Market - Room 2078, Wichita, or or conversion of a well. Rule 82-3-130, 82-3-106 and 82-3-107 apply. 2 months if requested in writing and submitted with the form (see rule 82-3-and geologist well report shall be attached with this form. ALL CEMENTING Submit CP-111 form with all temporarily abandoned wells.					
All requirements of the statutes, rules and regulations promulgated to regulatherein are complete and correct to the best of my knowledge.	te the oil and gas industry have been fully complied with and the statements					
Signature: Hay Allweller	KCC Office Use ONLY					
Operations Engineer December 27	2005 Letter of Confidentiality Attached					
Tius	If Denied, Yes Date:					
Subscribed and sworn to before me this 27 th_day of	ii Dalieu, Tes Date.					
1 000 W	Wireline Log Received					
16 <u>2005</u> .	Wireline Log Received Geologist Report Received					
Notary Public: Beverly &. Ford	Geologist Report Received UIC Distribution					

Operator Name:	Lario (Oil & Gas Company	Gas Company Lease Name: Clouse Well #: 4 RE/SWD				RE/SWD		
•	28 s. R. 6	☐ East	Count	y:	Kingman				
tested, time tool ope temperature, fluid re	en and closed, flowing covery, and flow rate	and base of formations p g and shut-in pressures, es if gas to surface test, a final geological well site	whether s long with	hut-in pre	essure reached	static level, hydr	ostatic pressur	es, bottom hole	
Drill Stem Tests Taken Yes No (Attach Additional Sheets)			✓ Log Formation (Top), D			epth and Datum Sample			
Samples Sent to Geological Survey		☐ Yes 🗹 No		Nam	е		Тор	Datum	
Cores Taken	ological cally	Yes No		Hee	bner Shale		2791	-1338	
Electric Log Run (Submit Copy)		✓ Yes No		Lans	sing		3065	-1612	
List All E. Logs Run:	:			Mari	maton		3601	-2148	
GR DIL CNL/CDL				Miss	sissippian		3860	-2407	
				Arbı	uckle		4381	-2928	
		CASING Report all strings set-	RECORD	✓ Neurface, interest		ction, etc.			
Purpose of String	Size Hole Drilled	Size Casing Set (In O.D.)	We	ight /FL	Setting Depth	Type of Cement	# Sacks Used	Type and Percent Additives	
Surface	13-3/4"	10-3/4"	40	/ 1 4	292'	Cernent	300	Additives	
Production	9" & 8-3/4"	7"	23		4559'	AA-2	225	10% salt + 1/4# CF	
								+ 0.8% FLA	
		ADDITIONAL	CEMENTI	ING / SQL	JEEZE RECORI)			
Purpose: Perforate Protect Casing Plug Back TD	Depth Top Bottom	Type of Cement	#Sacks Used		Type and Percent Additives				
Plug Off Zone									
Shots Per Foot	PERFORATI Specify	PERFORATION RECORD - Bridge Plugs Set/Type Specify Footage of Each Interval Perforated				Acid, Fracture, Shot, Cement Squeeze Record (Amount and Kind of Material Used) Depth			
4	3864' - 3874'				Acidize w/750 gal 15% MCA 3870				
					Frac w/28,000 gal N2 foamed Gel +				
					32,500# 12/20				
4	4480' - 4520'								
		****		-					
TUBING RECORD	Size 2-3/8"	Set At 3832/4360	Packer A 4360		Liner Run	Yes 🗸 No	•		
Date of First, Resumed	d Production, SWD or E	····		Flowing	y V Pumpi	ng Gas Li	ft 🔲 Othe	er (Explain)	
Estimated Production Per 24 Hours			Mcf	Wate		Bbls. (Gas-Oil Ratio	Gravity	
Disposition of Gas	METHOD OF C	8		48 8,000 30 Production Interval					
Vented ✓ Sold	Used on Lease	Open Hole	Perf	: v D	ually Comp.	Commingled			
(+0///04, 04		Other (Speci	ty)						

Clouse #4 RE/SWD

SW NE SE Sec. 13 - 28S - 06W Kingman Co., KS

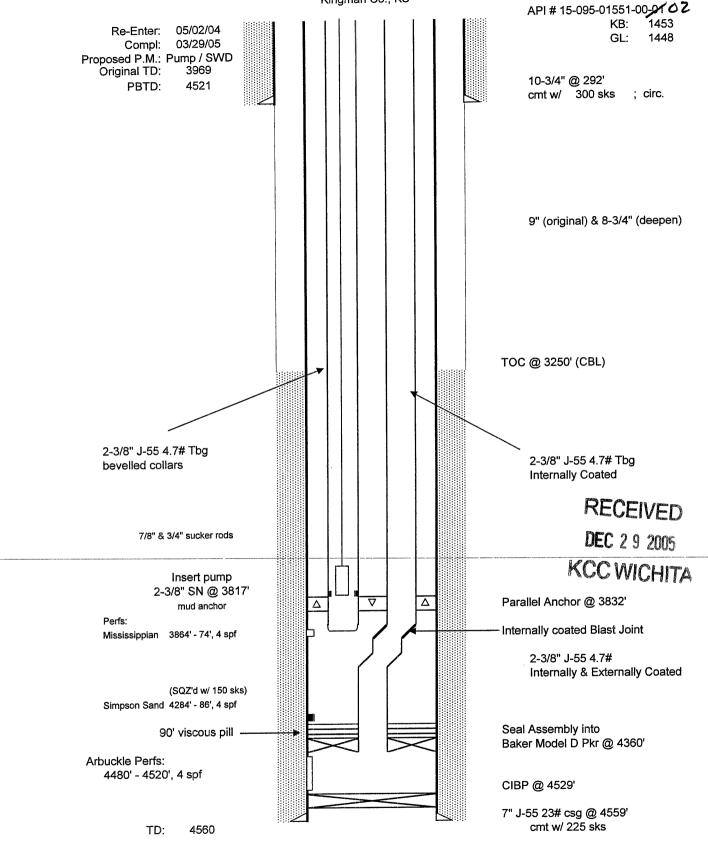

Prepared by: JGS Last Revision Date: 12/27/05

