

KANSAS CORPORATION COMMISSION
OIL & GAS CONSERVATION DIVISION

Form CP-1
September 2003
Form must be Typed
Form must be Signed
All blanks must be Filled

WELL PLUGGING APPLICATION

Please TYPE Form and File ONE Copy

API # 15- 093-21354-00-00 (Identifier Number of this well). This must be listed for wells drilled since 1967; if no API # was issued.

Indicate original spud or completion date S 3/23/94 C 6/09/94

Well Operator: BP AMERICA PRODUCTION COMPANY KCC License #: 5952

Address: P. O. BOX 3092, RM 3.276A, WL1 City: HOUSTON
(Owner/Company Name) (Operator's)

State: TEXAS Zip Code: 77253-3092 Contact Phone: 281 366-4395

Lease: SCHAEFER GAS UNIT Well #: 2HI Sec. 16 Twp. 23 S R. 35 W East West

SE NW NE Spot Location/QQQQ County KEARNY

1250 Feet from (in exact footage) North / South (from nearest outside section corner) Line of Section (not Lease Line)

1440 Feet from (in exact footage) East / West (from nearest outside section corner) Line of Section (not Lease Line)

Check One: Oil Well Gas Well D&A Cathodic Water Supply Well
 SWD Docket # _____ ENHR Docket # _____ Other _____

Conductor Casing Size: _____ Set at: _____ Cemented with: _____ Sacks

Surface Casing Size: 8 - 5/8" Set at: 1032' Cemented with: 450 Sacks

Production Casing Size: 5 - 1/2" Set at: 2805' Cemented with: 450 Sacks

List (ALL) Perforations and Bridgeplug Sets: 2530' - 2594'

Elevation: 3022' (G.L. K.B.) T.D. 2805' PBDT 2596' Anhydrite Depth _____
(Stone Corral Formation)

Condition of Well: Good Poor Casing Leak Junk in Hole

Proposed Method of Plugging (attach a separate page if additional space is needed): SEE ATTACHED PROCEDURE

RECEIVED
KANSAS CORPORATION COMMISSION

Is Well Log attached to this application as required? Yes No Is ACO-1 filed? Yes No

MAY 31 2007

If not explain why? _____

CONSERVATION DIVISION
WICHITA, KS

Plugging of this Well will be done in accordance with K.S.A. 55-101 et. seq. and the Rules and Regulations of the State Corporation Commission

List Name of Company Representative authorized to be in charge of plugging operations:

DEANN SMYERS Phone: 281 366-4395

Address: P. O. BOX 3092, RM 3.276A, WL1 City/State HOUSTON, TEXAS 77253-3092

Plugging Contractor HALLIBURTON SERVICES KCC License # 5287 99997
(Company Name) (Contractor's)

Address _____ Phone: _____

Proposed Date and Hour of Plugging (If known?): _____

Payment of the Plugging Fee (K.A.R. 82-3-118) will be guaranteed by Operator or Agent

Date: 5/30/2007 Authorized Operator / Agent: DeAnn Smyers
(Signature)

**Plugging Procedure for the Schaefer 2HI
Section 16 T23S R35W
Kearny County, Kansas**

NOTE – NOTIFY KCC DISTRICT OFFICE AT LEAST FIVE DAYS IN ADVANCE OF WORK.

This procedure was approved via email between Joe Eudey (BP representative) and Steve Durant (KCC) on May 15, 2007.

PROPOSED PROCEDURE:

1. Mix and pump 294 sacks of class C cement to fill the 5 1/2" casing from 2594' back to ground level. Mix 500 lbs of cottonseed hulls in the first part of the cement to seal off the perforations. Cement to contain 2% bentonite, to be mixed at 14.1 ppg with a 1.51 cuft/sk yield.
2. Have 50 extra sacks of cement to fill the 8 5/8" X 5 1/2" annulus.
3. Cut off and cap the casing 5' below ground level.
4. Restore the location.


RECEIVED
KANSAS CORPORATION COMMISSION
MAY 31 2007
CONSERVATION DIVISION
WICHITA, KS

Plugging Application
Schaefer 2HI - Abandonment
Sec 16, T23S, R35W
Kearny County, Kansas

The application attached is to abandon the Schaefer 2HI. BP Amoco is abandoning this well as it has become uneconomic to operate.

RECEIVED
KANSAS CORPORATION COMMISSION
MAY 31 2007
CONSERVATION DIVISION
WICHITA, KS

Schaefer 2HI
Section 16, T23S, R35W
Chase Formation
Hugoton Field
Kearny County, Kansas

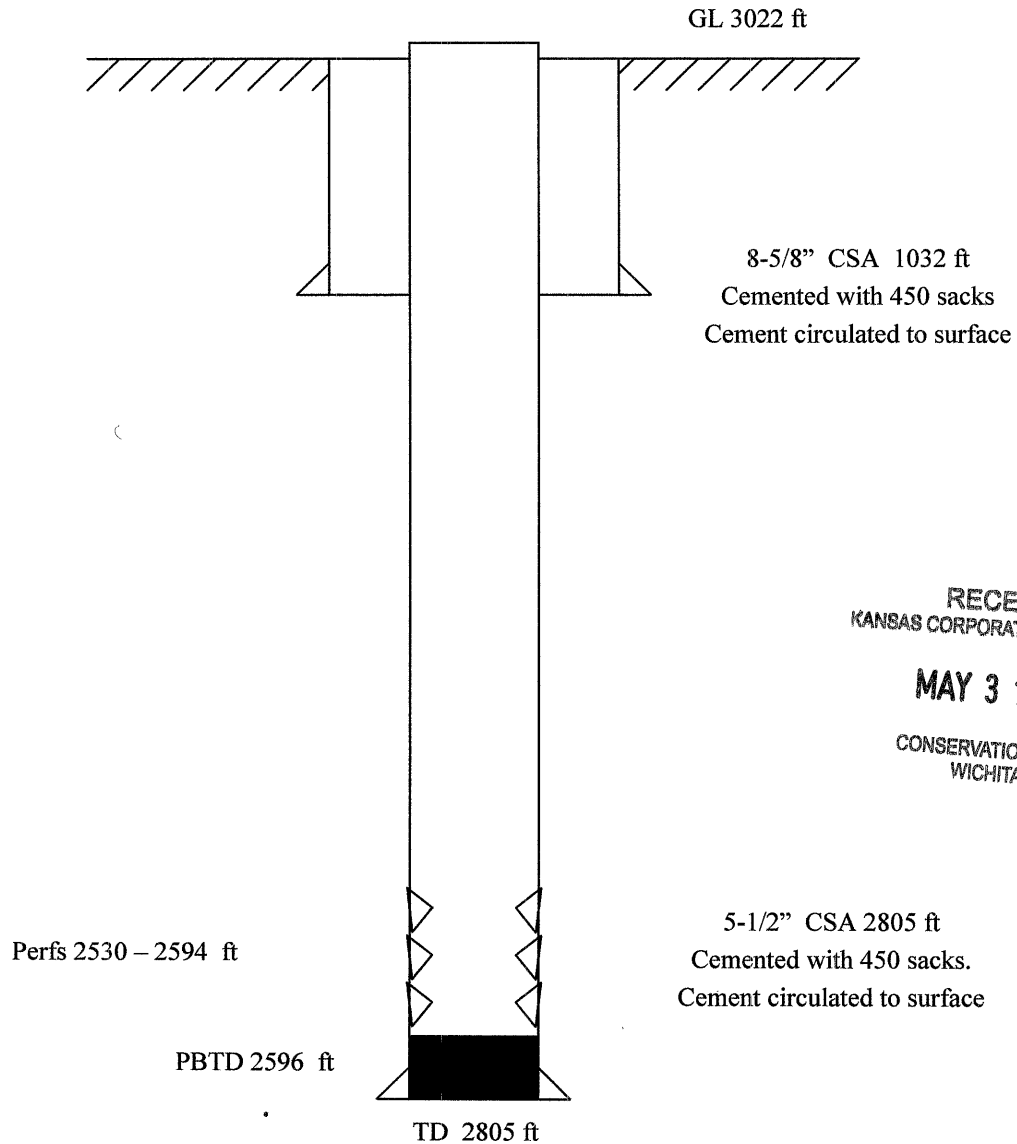


RECEIVED
KANSAS CORPORATION COMMISSION

MAY 3 1 2007

CONSERVATION DIVISION
WICHITA, KS

Not to scale

Schaefer 2HI
Section 16, T23S, R35W
Chase Formation
Hugoton Field
Kearny County, Kansas

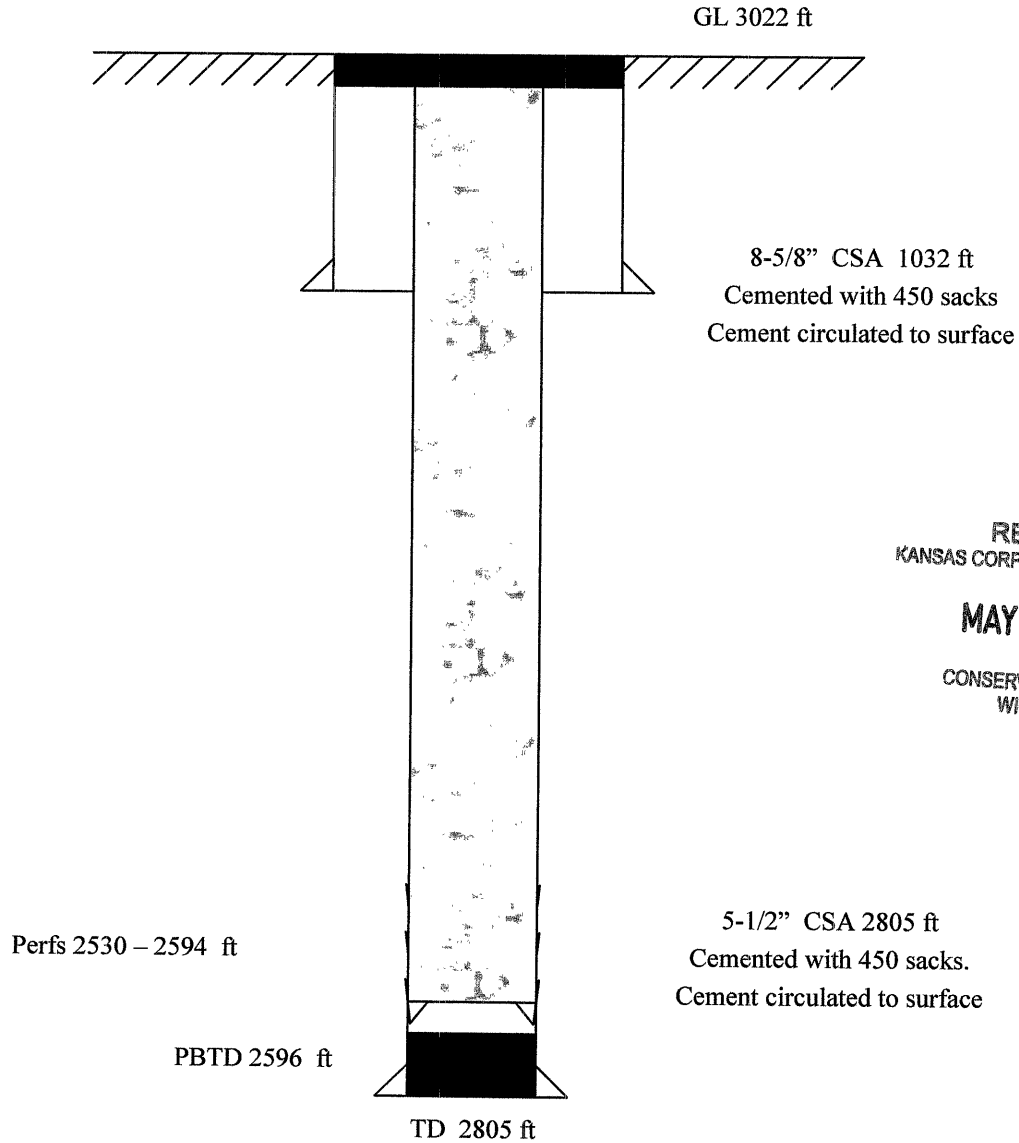

RECEIVED
KANSAS CORPORATION COMMISSION

MAY 31 2007

CONSERVATION DIVISION
WICHITA, KS

Not to scale



CORPORATION COMMISSION

Kathleen Sebelius, Governor Brian J. Moline, Chair Robert E. Krehbiel, Commissioner Michael C. Moffet, Commissioner

NOTICE OF RECEIPT OF WELL PLUGGING APPLICATION (CP-1)

BP AMERICA PRODUCTION COMPANY
2225 WEST OKLAHOMA AVENUE
ULYSSES, KS 67880

June 06, 2007

Re: SCHAEFER GU #2HI
API 15-093-21354-00-00
16-23S-35W, 1250 FNL 1440 FEL
KEARNY COUNTY, KANSAS

Dear Operator:

This letter is to notify you that the Conservation Division has received your plugging proposal, form CP-1, for the above well and has reviewed the proposal for completeness. The central office will now forward your CP-1 to the district office listed below for review of the proposed plugging method. **Please contact the district office for approval of your proposed plugging method at least five (5) days before plugging the well, pursuant to K.A.R. 82-3-113(b). If a workover pit will be used during the plugging of the well it must be permitted. A CDP-1 form must be filed and approved prior to the use of the pit in accordance with K.A.R. 82-3-600.**

The Conservation Division's review of form CP-1, either in the central or district office, does not include an inquiry into well ownership or the filing operator's legal right to plug the well. This notice in no way constitutes authorization to plug the above well by persons not having legal rights of ownership or interest in the well. **This notice is void after 180 days from its date. The CP-1 filing does not bring the above well into compliance with K.A.R. 82-3-111 with regard to the Commission's temporary abandonment requirements.**

Sincerely

Steve Bond

Production Department Supervisor

District: #1
210 E Frontview, Suite A
Dodge City, KS 67801
(620) 225-8888