

KANSAS CORPORATION COMMISSION
OIL & GAS CONSERVATION DIVISION

RECEIVED
KANSAS CORPORATION COMMISSION

JUN 01 2007

Form CP-1
September 2003

Form must be Typed
Form must be Signed
All blanks must be Filled

WELL PLUGGING APPLICATION

CONSERVATION DIVISION
WICHITA, KS

Please TYPE Form and File ONE Copy

API # 15- 093-20280 -00-00 (Identifier Number of this well). This must be listed for wells drilled since 1967; if no API # was issued.

Indicate original spud or completion date S 5/03/76 C 7/27/76

Well Operator: BP AMERICA PRODUCTION COMPANY KCC License #: 5952

Address: P. O. BOX 3092, RM 3.276A, WL1 City: HOUSTON (Operator's)

State: TEXAS Zip Code: 77253-3092 Contact Phone: 281 366-4395

Lease: KURZ GAS UNIT 'A' Well #: 2 Sec. 30 Twp. 24 S R. 37 W East West

C W2 E2 Spot Location/QQQQ County KEARNY

2250 Feet from (in exact footage) North / South (from nearest outside section corner) Line of Section (not Lease Line)

1850 Feet from (in exact footage) East / West (from nearest outside section corner) Line of Section (not Lease Line)

Check One: Oil Well Gas Well D&A Cathodic Water Supply Well
 SWD Docket # _____ ENHR Docket # _____ Other _____

Conductor Casing Size: _____ Set at: _____ Cemented with: _____ Sacks

Surface Casing Size: 8 - 5/8" Set at: 589' Cemented with: 400 Sacks

Production Casing Size: 5 - 1/2" Set at: 3022' Cemented with: 850 Sacks

List (ALL) Perforations and Bridgeplug Sets: 2827'-2928'

Elevation: 3253' (G.L. K.B.) T.D. 3022' PBD 3018' Anhydrite Depth _____
(Stone Corral Formation)

Condition of Well: Good Poor Casing Leak Junk in Hole

Proposed Method of Plugging (attach a separate page if additional space is needed): SEE ATTACHED PROCEDURE

Bad casing from 2117-2233 feet. Found several leaks

Is Well Log attached to this application as required? Yes No Is ACO-1 filed? Yes No

If not explain why? _____

Plugging of this Well will be done in accordance with K.S.A. 55-101 et. seq. and the Rules and Regulations of the State Corporation Commission

List Name of Company Representative authorized to be in charge of plugging operations:

DEANN SMYERS Phone: 281 366-4395

Address: P. O. BOX 3092, RM 3.276A, WL1 City/State HOUSTON, TEXAS 77253-3092

Plugging Contractor HALLIBURTON SERVICES KCC License # 5287
(Company Name) (Contractor's)

Address _____ Phone: _____

Proposed Date and Hour of Plugging (If known?): _____

Payment of the Plugging Fee (K.A.R. 82-3-118) will be guaranteed by Operator or Agent

Date: 5/31/2007 Authorized Operator / Agent: Deann Smyers
(Signature)

**Plugging Procedure for the Kurz A 2
Section 30 T24S R37W
Kearny County, Kansas**

NOTE – NOTIFY KCC DISTRICT OFFICE AT LEAST FIVE DAYS IN ADVANCE OF WORK.

This procedure was approved via email between Joe Eudey (BP representative) and Steve Durant (KCC) on April 19, 2007.

PROPOSED PROCEDURE:


1. Set a CIBP at 2780'. Dump 2 sacks of cement on top of plug.
2. Confirm that we can establish an injection rate into the holes in the casing.
3. Mix and pump 268 sacks of cement to fill the casing from the hole at 2117 to ground level. Use cottonseed hulls in the lead slurry to seal off the leak.
4. Have 50 extra sacks of cement on location to fill the annulus, as needed.
5. Cut off and cap the casing 4' below ground level.
6. Restore the location.

RECEIVED
KANSAS CORPORATION COMMISSION

JUN 01 2007

CONSERVATION DIVISION
WICHITA, KS

Kurz A 2
Section 30, T24S, R37W
Council Grove Formation
Panoma Field
Kearny County, Kansas

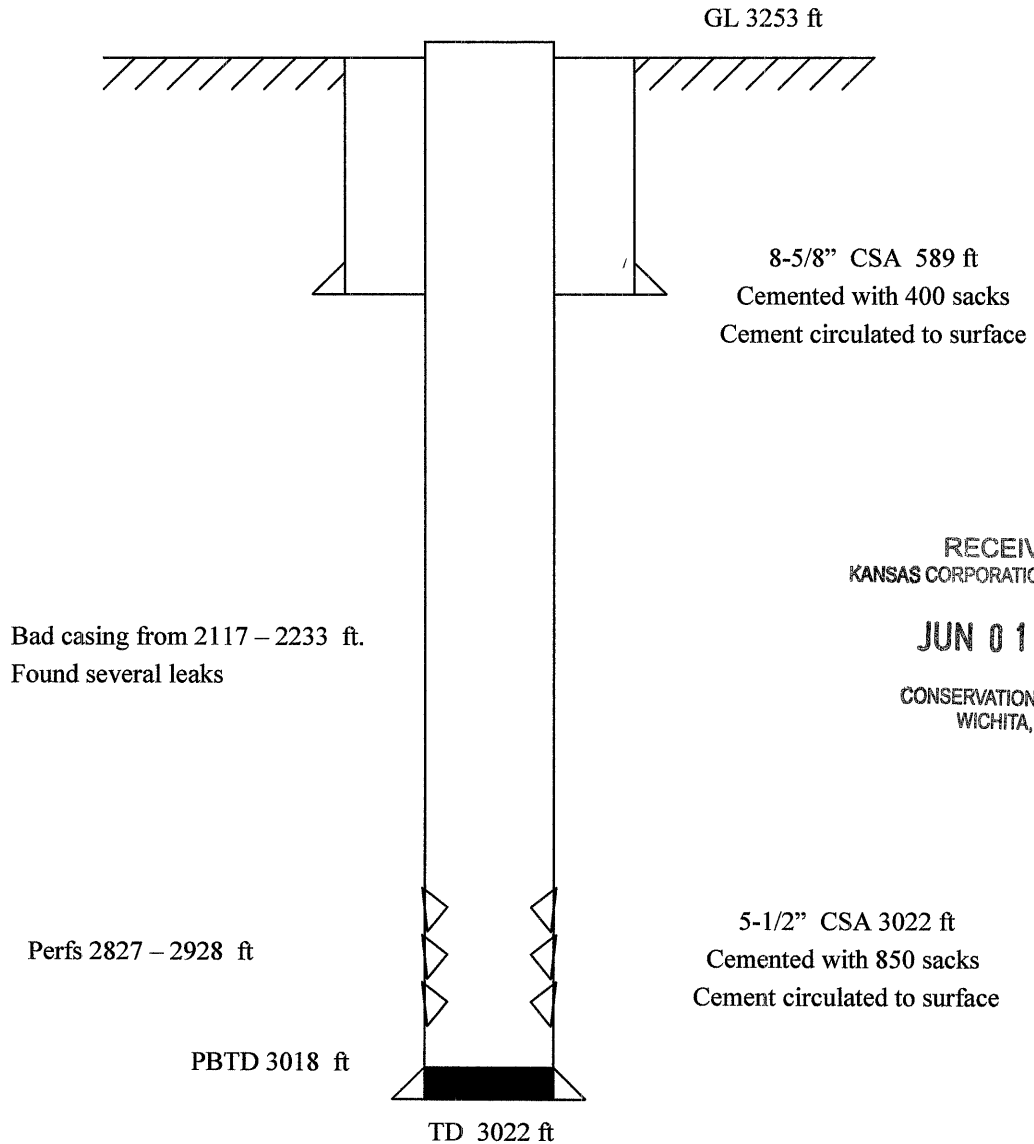

RECEIVED
KANSAS CORPORATION COMMISSION

JUN 01 2007

CONSERVATION DIVISION
WICHITA, KS

Not to scale

Plugging Application
Kurz A 2 - Abandonment
Sec 30, T24S, R37W
Kearny County, Kansas


The application attached is to abandon the Kurz A 2. BP Amoco is abandoning this well as it has become uneconomic to operate.

RECEIVED
KANSAS CORPORATION COMMISSION

JUN 01 2007

CONSERVATION DIVISION
WICHITA, KS

Kurz A 2
Section 30, T24S, R37W
Council Grove Formation
Panoma Field
Kearny County, Kansas

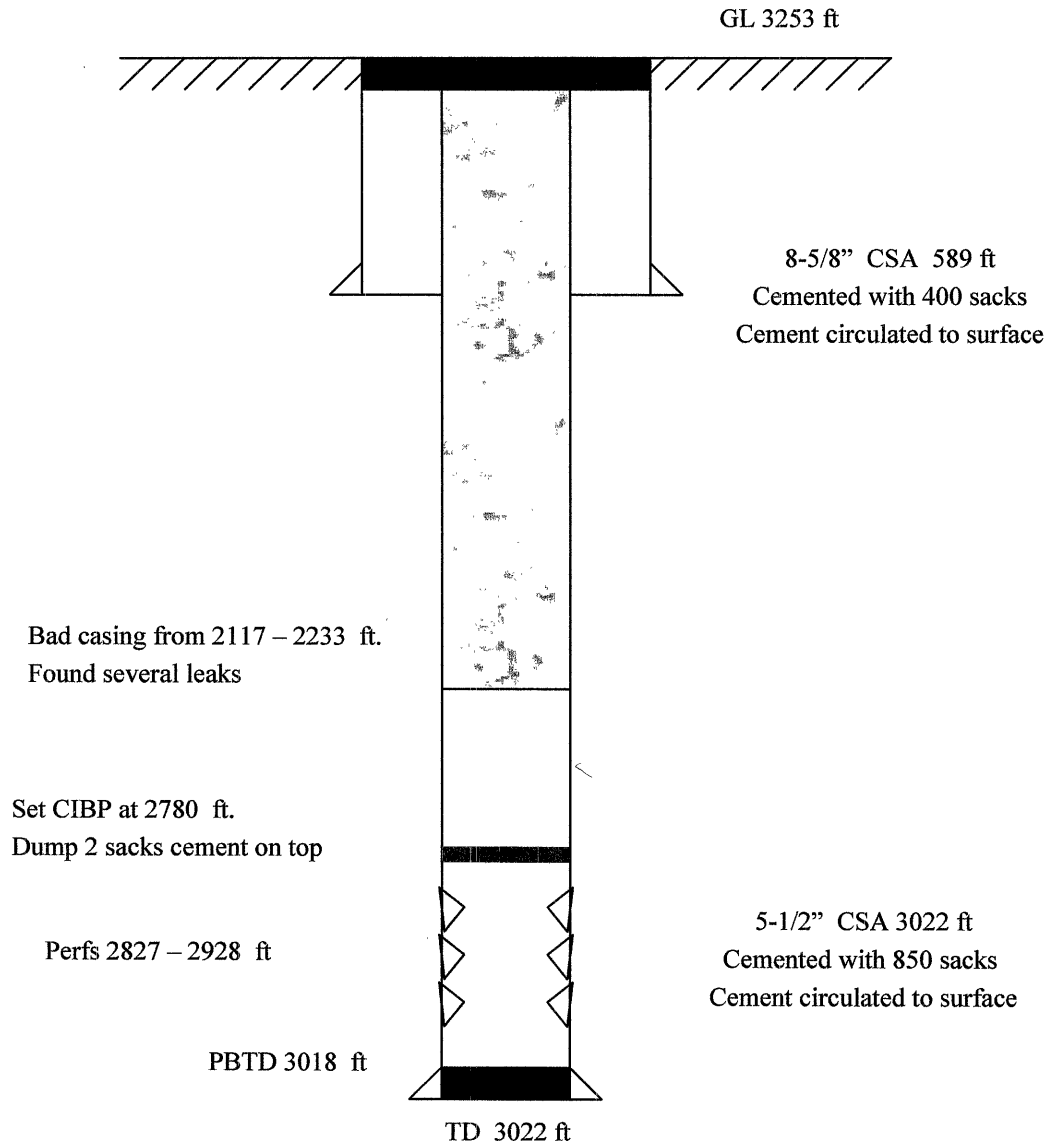

Not to scale



CORPORATION COMMISSION

Kathleen Sebelius, Governor Brian J. Moline, Chair Robert E. Krehbiel, Commissioner Michael C. Moffet, Commissioner

NOTICE OF RECEIPT OF WELL PLUGGING APPLICATION (CP-1)

BP AMERICA PRODUCTION COMPANY
2225 WEST OKLAHOMA AVENUE
ULYSSES, KS 67880

June 06, 2007

Re: KURZ GU A #2
API 15-093-20280-00-00
30-24S-37W, 2550 FNL 1850 FEL
KEARNY COUNTY, KANSAS

Dear Operator:

This letter is to notify you that the Conservation Division has received your plugging proposal, form CP-1, for the above well and has reviewed the proposal for completeness. The central office will now forward your CP-1 to the district office listed below for review of the proposed plugging method. **Please contact the district office for approval of your proposed plugging method at least five (5) days before plugging the well, pursuant to K.A.R. 82-3-113(b). If a workover pit will be used during the plugging of the well it must be permitted. A CDP-1 form must be filed and approved prior to the use of the pit in accordance with K.A.R. 82-3-600.**

The Conservation Division's review of form CP-1, either in the central or district office, does not include an inquiry into well ownership or the filing operator's legal right to plug the well. This notice in no way constitutes authorization to plug the above well by persons not having legal rights of ownership or interest in the well. **This notice is void after 180 days from its date. The CP-1 filing does not bring the above well into compliance with K.A.R. 82-3-111 with regard to the Commission's temporary abandonment requirements.**

Sincerely

Steve Bond
Production Department Supervisor

District: #1
210 E Frontview, Suite A
Dodge City, KS 67801
(620) 225-8888