

KANSAS CORPORATION COMMISSION
OIL & GAS CONSERVATION DIVISION

WELL PLUGGING APPLICATION

Please TYPE Form and File ONE Copy

Form CP-1
September 2003
Form must be Typed
Form must be Signed
All blanks must be Filled

API # 15- 129-10130-00-01 (Identifier Number of this well). This must be listed for wells drilled since 1967; if no API # was issued.

Indicate original spud or completion date S 1/03/61 C 3/03/61

Well Operator: BP AMERICA PRODUCTION COMPANY KCC License #: 5952
(Owner/Company Name) (Operator's)

Address: P. O. BOX 3092, RM 3.276A, WL1 City: HOUSTON

State: TEXAS Zip Code: 77253-3092 Contact Phone: 281 366-4395

Lease: J. C. Shimer Gas Unit B Well #: 1 Sec. 36 Twp. 31 S R. 40 W ☐ East ☒ West

C NW Spot Location/QQQQ County MORTON

3960 Feet from (in exact footage) ☐ North / ☒ South (from nearest outside section corner) Line of Section (not Lease Line)

3960 Feet from (in exact footage) ☒ East / ☐ West (from nearest outside section corner) Line of Section (not Lease Line)

Check One: ☐ Oil Well ☒ Gas Well ☐ D&A ☐ Cathodic ☐ Water Supply Well
☐ SWD Docket # _____ ☐ ENHR Docket # _____ ☐ Other _____

Conductor Casing Size: _____ Set at: _____ Cemented with: _____ Sacks

Surface Casing Size: 9 - 5/8" Set at: 709' Cemented with: 450 Sacks

Production Casing Size: 4 - 1/2" Set at: 5791' Cemented with: 150 Sacks

List (ALL) Perforations and Bridgeplug Sets: 2642'-2771', Morrow Perfs 5396'-5712'

Elevation: 3246' (☒ G.L. ☐ K.B.) T.D. 6000' PBDT _____ Anhydrite Depth _____
(Stone Corral Formation)

Condition of Well: ☐ Good ☐ Poor ☒ Casing Leak ☐ Junk in Hole

Proposed Method of Plugging (attach a separate page if additional space is needed): Bad casing from 1008'-1806'. Found several leaks. SEE ATTACHED PROCEDURE

Is Well Log attached to this application as required? ☒ Yes ☐ No Is ACO-1 filed? ☒ Yes ☐ No

If not explain why? _____

Plugging of this Well will be done in accordance with K.S.A. 55-101 et. seq. and the Rules and Regulations of the State Corporation Commission

List Name of Company Representative authorized to be in charge of plugging operations:

DEANN SMYERS Phone: 281 366-4395

Address: P. O. BOX 3092, RM 3.276A, WL1 City/State HOUSTON, TEXAS 77253-3092

Plugging Contractor HALL BURTON SERVICES KCC License # 5287 99997
(Company Name) (Contractor's)

Address _____ Phone: _____

Proposed Date and Hour of Plugging (if known?): _____

Payment of the Plugging Fee (K.A.R. 82-3-118) will be guaranteed by Operator or Agent

Date: 4/12/2007 Authorized Operator / Agent: Deann Smyers
(Signature)

RECEIVED
KANSAS CORPORATION COMMISSION
APR 18 2007
CONSERVATION DIVISION
WICHITA, KS

Plugging Application
J. C. Shimer B 1 - Abandonment
Sec 36, T31S, R40W
Morton County, Kansas

The application attached is to abandon the J. C. Shimer B 1. BP Amoco is abandoning this well as it has become uneconomic to operate.

RECEIVED
KANSAS CORPORATION COMMISSION

APR 18 2007

CONSERVATION DIVISION
WICHITA, KS

**Plugging Procedure for the J. C. Shimer B 1
Section 36 T31S R40W
Morton County, Kansas**

NOTE – NOTIFY KCC DISTRICT OFFICE AT LEAST FIVE DAYS IN ADVANCE OF WORK.

This procedure was approved via email between Joe Eudey (BP representative) and Steve Durant (KCC) on April 5, 2007.

PROPOSED PROCEDURE:

Set CIBP at 2600'. Dump 2 sacks of cement on top of plug

Set CIBP at 750'

Perforate circulating holes at 710'

Mix and pump cement down the 4 1/2" casing, through the circulating holes, and out the 9 5/8" X 4 1/2" annulus, leaving the 4 1/2" casing and the annulus full of cement.

Cement blend to be Class "C", mixed at 14.8 ppg, with a yield of 1.32 cuft/sk. This should take approximately 300 sacks of cement, including excess.

Cut off and cap the casing 5' below ground level.


Restore the location.

RECEIVED
KANSAS CORPORATION COMMISSION

APR 18 2007

CONSERVATION DIVISION
WICHITA, KS

J. C. Shimer B 1
Section 36, T31S, R40W
Council Grove Formation
Panoma Field
Morton County, Kansas

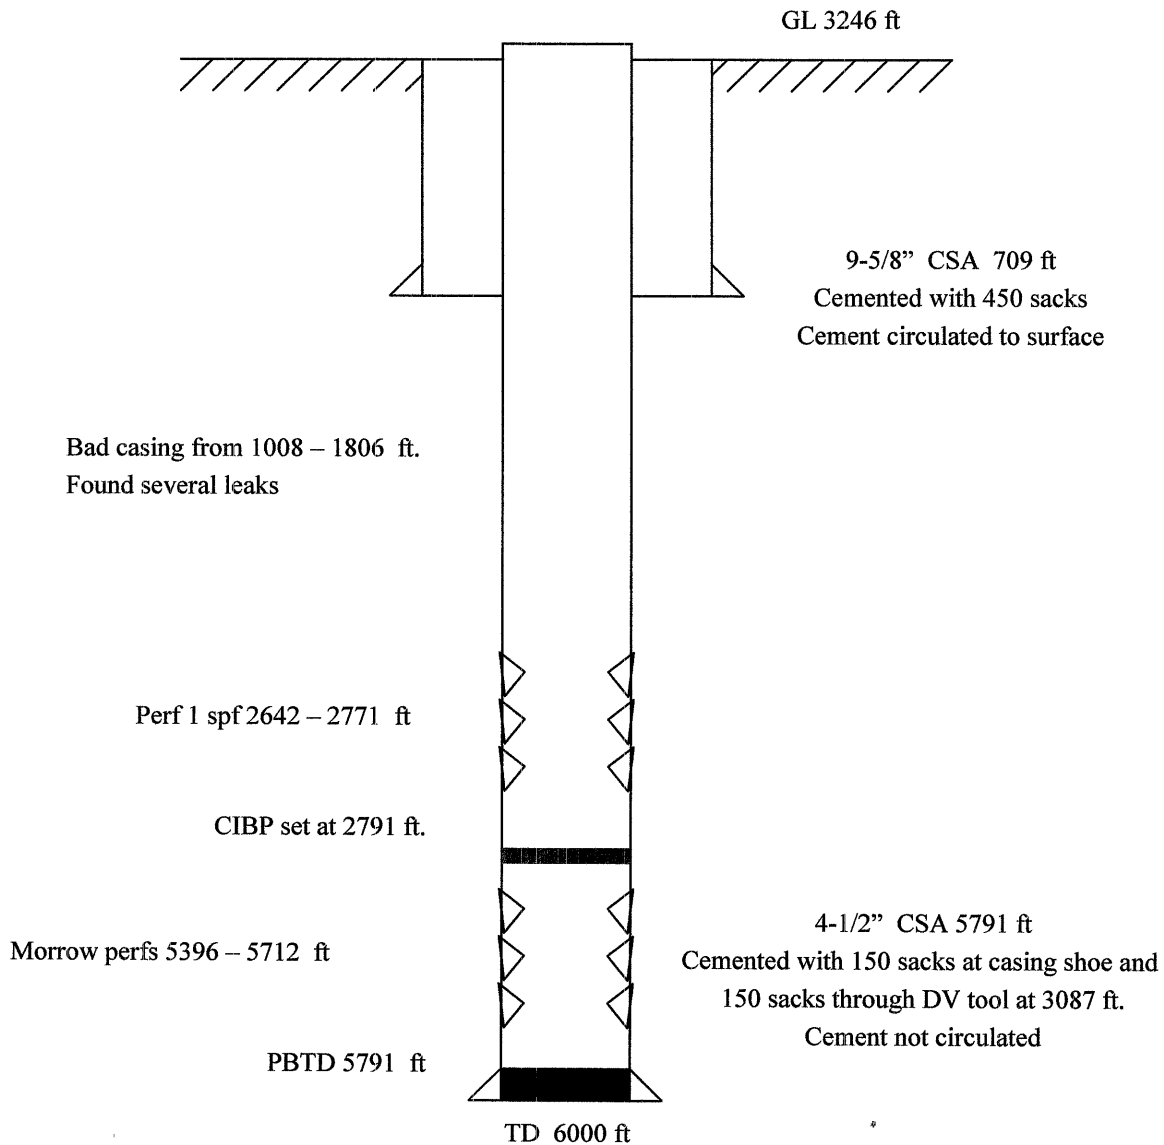


Not to scale

RECEIVED
KANSAS CORPORATION COMMISSION

APR 18 2007

CONSERVATION DIVISION
WICHITA, KS

J. C. Shimer B 1
Section 36, T31S, R40W
Council Grove Formation
Panoma Field
Morton County, Kansas

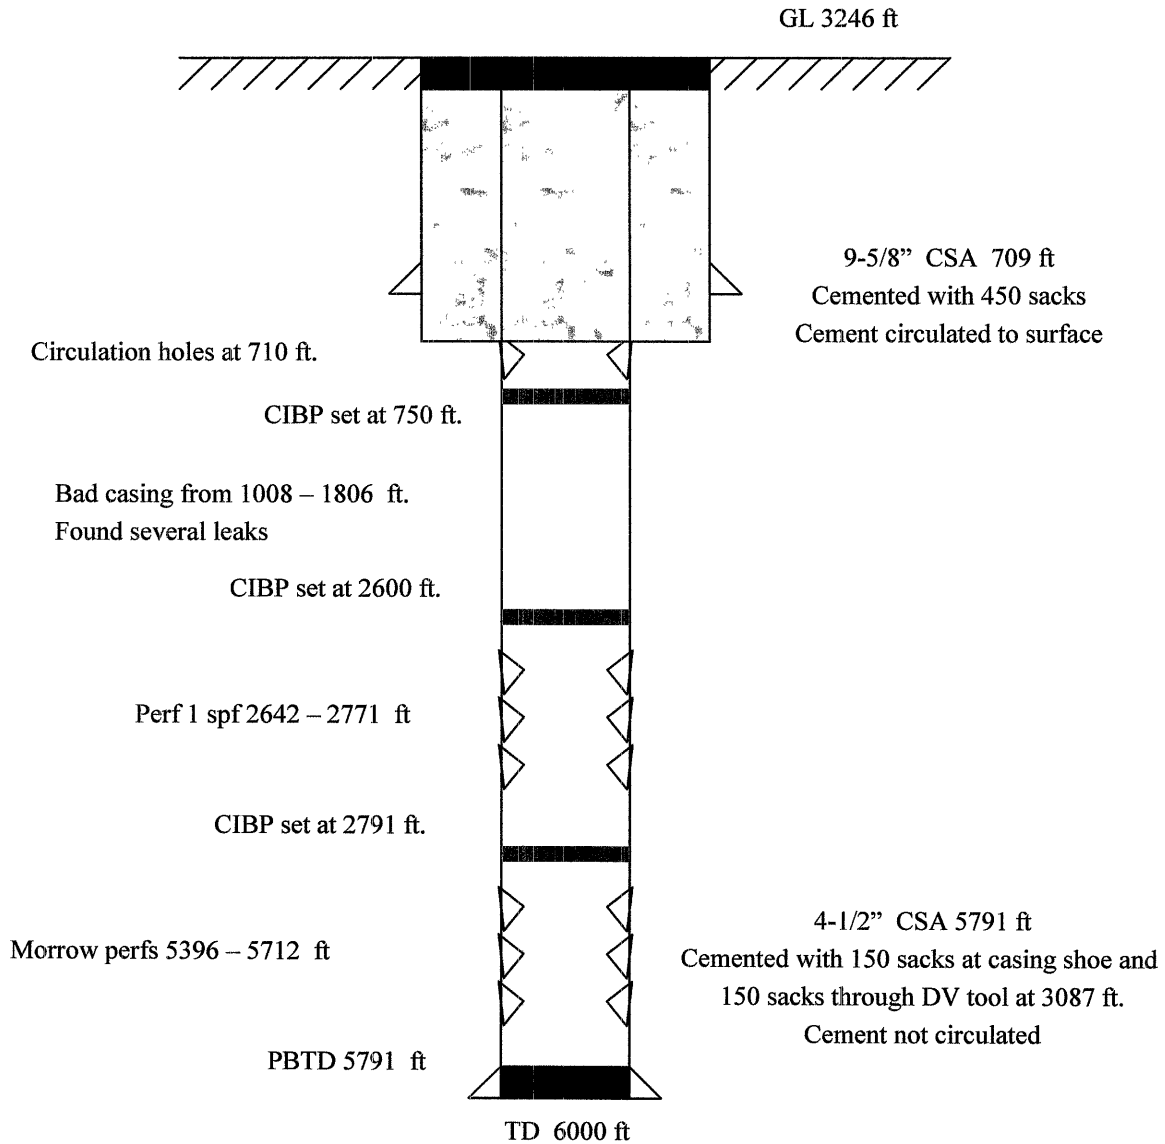

Not to scale

RECEIVED
KANSAS CORPORATION COMMISSION

APR 18 2007

CONSERVATION DIVISION
WICHITA, KS



Kathleen Sebelius, Governor Brian J. Moline, Chair Robert E. Krehbiel, Commissioner Michael C. Moffet, Commissioner

NOTICE OF RECEIPT OF WELL PLUGGING APPLICATION (CP-1)

BP America Production Company
2225 West Oklahoma Avenue
Ulysses, KS 67880

April 18, 2007

Re: J.C. SHIMER GAS UNIT B #1
API 15-129-10130-00-00
NW 36-31S-40W, 3960 FSL 3960 FEL
MORTON COUNTY, KANSAS

Dear Operator:

This letter is to notify you that the Conservation Division is in receipt of your plugging proposal, form CP-1, for the above-captioned well.

Your CP-1 has been reviewed by the Conservation Division central office for completeness and to verify license numbers. The plugging proposal will now be forwarded to the district office listed below for review of your proposed method of plugging.

Please contact the district office for approval of your proposed plugging method at least five (5) days before plugging the well, pursuant to K.A.R. 82-3-113 (b). If a workover pit will be used during the plugging of the well it must be permitted. A CDP-1 form must be filed and approved prior to the use of the pit.

The Conservation Division's review of form CP-1, either in the central or district office, does not include an inquiry into well ownership or the filing operator's legal right to plug the well.

This notice in no way constitutes authorization to plug the above-captioned well by persons not having legal rights of ownership or interest in the well. This notice is void after ninety (90) days from the above date.

District: #1
210 E Frontview, Suite A
Dodge City, KS 67801
(620) 225-8888

Sincerely

Barry Metz
Deputy Director