


WELL PLUGGING RECORD

Give All Information Completely
Make Required Affidavit
Mail or Deliver Report to:
Conservation Division
State Corporation Commission
211 No. Broadway
Wichita, Kansas

NORTH

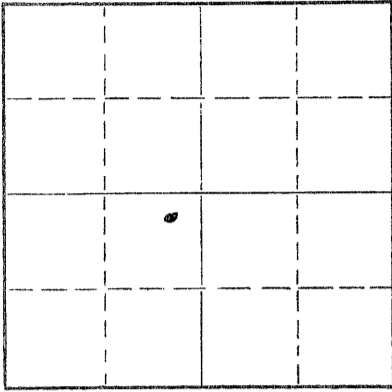

Locate well correctly on above
Section Plat

ooks County, Sec. 32 Twp. 10S Rge. 17 (E) W (W)
Location as "NE/CNW/SW" or footage from lines NW NW SW
Lease Owner Green Pipe & Supply Co.
Lease Name Ridley Well No. "K" # 1
Office Address 817 Wright Bldg. Tulsa Oklahoma
Character of Well (completed as Oil, Gas or Dry Hole) oil
Date well completed 2-1954 19 54
Application for plugging filed _____ 19 _____
Application for plugging approved MAY 11 19 64
Plugging commenced June 2 19 64
Plugging completed June 3 19 64
Reason for abandonment of well or producing formation _____
NO production

If a producing well is abandoned, date of last production _____ 19 _____
Was permission obtained from the Conservation Division or its agents before plugging was commenced? YES

Name of Conservation Agent who supervised plugging of this well ELDON PETTY
Producing formation AR BUCKLE Depth to top 3612 Bottom 3658 Total Depth of Well 3658 Feet
Show depth and thickness of all water, oil and gas formations.

OIL, GAS OR WATER RECORDS

CASING RECORD

FORMATION	CONTENT	FROM	TO	SIZE	PUT IN	PULLED OUT
				8 5/8	192	0
				5 1/2	3476	2494

Describe in detail the manner in which the well was plugged, indicating where the mud fluid was placed and the method or methods used in introducing it into the hole. If cement or other plugs were used, state the character of same and depth placed, from _____ feet to _____ feet for each plug set.

Dump 4 St Cement at 2900' with Dump Bales
Shot Pipe & Pulled to 500'; Circled Mud with Pump Truck
Spotted 20 St of Cement at 500'; Pulled Pipe to 200'; Pumped
20 St of Cement at 200' Pulled Pipe to 30' & Pumped 10 St in
top of Surface pipe.

RECEIVED
STATE CORPORATION COMMISSION

JUN 18 1964
06-18-1964
CONSERVATION DIVISION
Wichita, Kansas

Name of Plugging Contractor Bert Seif # 48
Address Rt. # 4 Hutchinson Kansas

STATE OF Kansas, COUNTY OF Deer, ss.

(employee of owner) or (owner or operator) of the above-described well, being first duly sworn on oath, says: That I have knowledge of the facts, statements, and matters herein contained and the log of the above-described well as filed and that the same are true and correct. So help me God.

(Signature) Bert Seif

SUBSCRIBED AND SWORN TO before me this 8 day of June, 19 64

My commission expires Oct. 18, 1965
Moethy Gey
Notary Public.



WELL LOG

15-163-00526-00-00
00726

COMPANY The Bay Petroleum Corporation

SEC. 32 T. 10 R. 17N

FARM Ridler "K" NO. 1

LOC. NW 1/4 NW 1/4 SW 1/4

TOTAL DEPTH 3658'

COMM. 1-8-54


COMP. 1-25-54

SHOT OR TREATED

CONTRACTOR Lewis Drilling Company

ISSUED

COUNTY Roooks
KANSAS

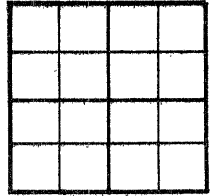

CASING

20	10		
15	8X 8-5/8"	192'	
12	6		
13	8X 5-1/2"	3476'	

ELEVATION

PRODUCTION

FIGURES INDICATE BOTTOM OF FORMATIONS

0	=	192	Shale
192	=	825	Shale & Shells
825	=	915	Sand
915	=	1310	Shale & Shells
1310	=	1335	Anhydrite
1335	=	2475	Shale & Lime
2475	=	2560	Shale
2560	=	3200	Shale & Lime
3200	=	3220	Shale
3220	=	3250	Lime & Shale
3250	=	3289	Lime
3289	=	3320	Lime & Shale
3320	=	3490	Lime
3490	=	3560	Lime & Shale
3560	=	3590	Conglomerate
3590	=	3594	Lime
3594	=	3612	Conglomerate
3612	=	3658	Arbuckle Lime
3658	=	T.D.	

RECEIVED
STATE CORPORATION COMMISSION

JUN 18 1964
06-18-1964
CONSERVATION DIVISION
Wichita, Kansas

State of KANSAS
County of SEDERWICK } ss:

I, L. L. Bailey of the Lewis Drilling Company
upon oath state that the above and foregoing is a true and correct copy of the log of the Ridler "K" #1 well.

L. L. Bailey

Subscribed and sworn to before me this 30th day of January 19 54

My Commission Expires: August 20, 1956

Arthur R. Derrington
NOTARY PUBLIC