

15-163-00071-00-00

STATE OF KANSAS
STATE CORPORATION COMMISSION


WELL PLUGGING RECORD

Give All Information Completely
Make Required Affidavit
Mail or Deliver Report to:
Conservation Division
State Corporation Commission
800 Bitting Building
Wichita, Kansas

FORMATION PLUGGING RECORD

Strike out upper line
when reporting plugging
off formations.

NORTH

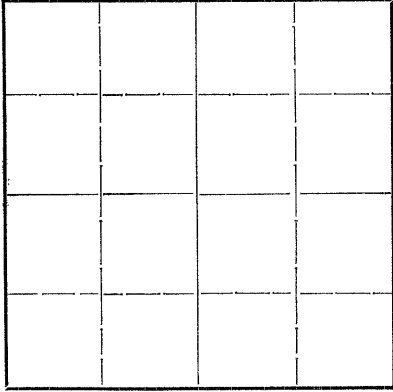

Locate well correctly on above Section Plat

ROOKS County. Sec. 32 Twp. 10 Rge. 17 (W) ^{KCPG}
Location as "NE $\frac{1}{4}$ NW $\frac{1}{4}$ SW $\frac{1}{4}$ " or footage from lines ~~97 97 174~~ 52 SW NE
Lease Owner Seaney & Clampitt
Lease Name Morrison Well No. 1
Office Address 1002 Stanley, Wichita, Kansas
Character of Well (completed as Oil, Gas or Dry Hole) Dry Hole
Date, well completed 19..
Application for plugging filed May 1, 19 40
Application for plugging approved May 1, 19 40
Plugging Commenced April 29, 19 40
Plugging Completed May 1, 19 40
Reason for abandonment of well or producing formation Dry Hole

If a producing well is abandoned, date of last production 19..
Was permission obtained from the Conservation Division or its agents before plugging was commenced? Yes

Name of Conservation Agent who supervised plugging of this well C. T. Alexander, Great Bend
Producing formation Depth to top Bottom Total Depth of Well 3681 Feet

Show depth and thickness of all water, oil and gas formations.



OIL, GAS OR WATER RECORDS

CASING RECORD

Formation	Content	From	To	Size	Put In	Pulled Out

Describe in detail the manner in which the well was plugged, indicating where the mud fluid was placed and the method or methods used in introducing it into the hole. If cement or other plugs were used, state the character of same and depth placed, from.....feet tofeet for each plug set.

Hole filled with mud from 3681' to 300'
Hole bridged at 300' and a 15-foot cement plug set on bridge.
Mud to 6' of bottom of cellar and cement to top of surface pipe at bottom of cellar.

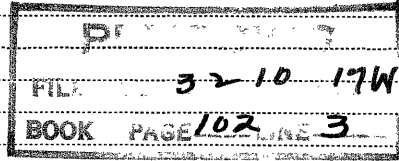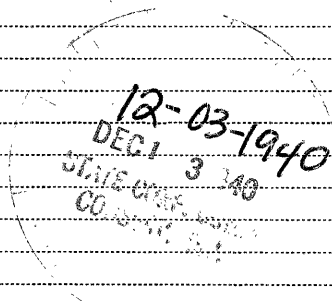

(If additional description is necessary, use BACK of this sheet)

Correspondence regarding this well should be addressed to Seaney & Clampitt
Address 1002 Stanley, Wichita, Kansas

STATE OF KANSAS, COUNTY OF SEDGWICK, ss.
Chas. Seaney (employer of owner) or (owner or operator) of the above-described well, being first duly sworn on oath, says: That I have knowledge of the facts, statements, and matters herein contained and the log of the above-described well as filed and that the same are true and correct. So help me God.
(Signature) Seaney & Clampitt Charles Seaney
1002 Stanley, Wichita, Kansas (Address)

SUBSCRIBED AND SWORN to before me this 13th day of December 19 40
My commission expires Nov. 25, 1943
Emogene Whitfield Notary Public.

WELL LOG BUREAU - KANSAS GEOLOGICAL SOCIETY
412 Union National Bk Bldg., Wichita, Kansas


15-163-00071-00-00

LARIO OIL & GAS CO.
Morrison No. 1.

SEC. 32 T. 10 R. 17W
CSL SW NE

Total Depth. 3681'
Comm. 4-3-40 Comp. 4-29-40
Shot or Treated.
Contractor. Seaney & Clampitt
Issued. 5-18-40

County. Rooks

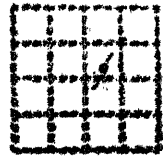

CASING:
12 1/2" 57'

Elevation.

Production. Dry

Figures Indicate Bottom of Formations.

chalk	45	chert & conglomerate	3586
shale blue	487	chert & red rock	3612
shale	510	chert	3614
sand & shale	770	shale & lime	3630
shale & shells	830	shale red	3644
sand	990	shale	3647
shale sticky	1000	S. shale	3660
red bed	1030	lime	3681
shale & pyrite	1080	Total Depth.	
red rock & pyrite	1095		
shale	1150		
no log	1205		
shale	1295		
lime	1348		
shale & shells	1370		
shale & lime	1440	Top Anhydrite	1295
shale	1475	Base Kansas City	3530
shale & shells	1565	Top Conglomerate	3571
shale	1595	Top Simpson	3634
lime shells & shale	1630	Top Arbuckle	3661
shale & pyrite	1642		
shale & shells	1696		
shale & salt	1757		
salt, shale, shells	1845		
shale & shells	1890		
lime	2000		
shale & lime	2033		
shale	2140		
lime	2195		
shale	2210		
lime brkn	2232		
lime	2260		
shale	2270		
lime	2285		
shale	2293		
shale & lime	2329		
shale	2370		
lime	2390		
shale	2400		
shale & lime	2438		
shale	2465		
sdv lime sft	2485		
shale	2505		
shale & lime	2545		
shale	2661		
shale & lime	2857		
shale	2892		
Steel line @	2830		
OK			
brkn lime & shale	2955		
shale	3078		
lime	3176		
shale	3202		
lime	3262		
shale	3279		
shale & lime	3315		
lime (sh oil 3365-70)	3369		
shale & lime	3409		
lime	3534		
shale & lime	3565		
lime	3571		

