


STATE OF KANSAS  
STATE CORPORATION COMMISSION

WELL PLUGGING RECORD

Give All Information Completely  
Make Required Affidavit  
Mail or Deliver Report to  
Conservation Division  
State Corporation Comm.  
245 North Water  
Wichita, KS 67202

ROOKS County, Sec. 30 Twp. 10S Rge. 17W E/W  
Location as "NE/CNW $\frac{1}{4}$ SW $\frac{1}{4}$ " or footage from lines  
NW SE SW

Lease Owner LIBERTY ENTERPRISES, INC.  
Lease Name SCHMIDT Well No. 1  
Office Address 305 W MILLS PLAINVILLE, KANSAS 67663  
Character of Well (Completed as Oil, Gas or Dry Hole)

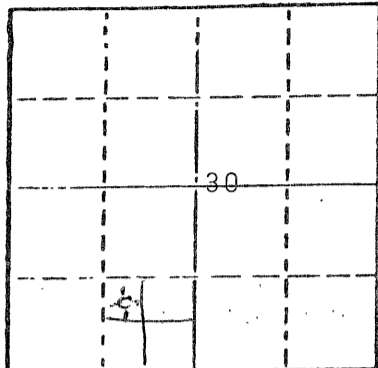

Locate well correctly on above Section Map

DRY HOLE  
Date Well completed FEBRUARY 9 1977  
Application for plugging filed FEBRUARY 9 1977  
Application for plugging approved FEBRUARY 9 1977  
Plugging commenced FEBRUARY 9 1977  
Plugging completed FEBRUARY 9 1977

Reason for abandonment of well or producing formation  
PLUGGED & ABANDONED  
If a producing well is abandoned, date of last production 19

Was permission obtained from the Conservation Division or its agents before plugging was commenced? YES

Name of Conservation Agent who supervised plugging of this well LEO F MASSEY  
Producing formation \_\_\_\_\_ Depth to top \_\_\_\_\_ Bottom \_\_\_\_\_ Total Depth of Well \_\_\_\_\_  
Show depth and thickness of all water, oil and gas formations.

OIL, GAS OR WATER RECORDS

CASING RECORD

FORMATION	CONTENT	FROM	TO	SIZE	PUT IN	PULLED OUT
				8 5/8	210.15'	NONE

Describe in detail the manner in which the well was plugged, indicating where the mud fluid was placed and the method or methods used in introducing it into the hold. If cement or other plugs were used, state the character of same and depth placed, from \_\_\_\_\_ feet to \_\_\_\_\_ feet for each plug set.

FILLED HOLE WITH HEAVY MUD TO 600'.  
SET PLUG. PUT IN 70 SACKS CEMENT.  
FILLED WITH HEAVY MUD TO 185'. SET  
PLUG. PUT IN 20 SACKS CEMENT.  
FILLED WITH HEAVY MUD TO 40'. SET  
PLUG. FILLED TO TOP WITH 50-50 POZMIX  
(10 SACKS) + 6% GEL.

RECEIVED  
STATE CORPORATION COMMISSION  
FEB 22 1977  
02-22-1977  
CONSERVATION DIVISION  
Wichita, Kansas

(If additional description is necessary, use BACK of this sheet)

Name of Plugging Contractor C-G DRILLING CO.

STATE OF KANSAS COUNTY OF SEDGWICK ss.  
Jay H Galloway (employee of owner) or (owner or operator) of the above-described

well, being first duly sworn on oath, says: That I have knowledge of the facts, statements, and matters herein contained and the log of the above-described well as filed and that the same are true and correct. So help me God.

(Signature) Jay H Galloway  
1107 Douglas Building, 104 S. Bwby.  
February 1977

SUBSCRIBED AND SWORN TO before me this 14th day of February 1977

My commission expires December 8, 1979  
Phyllis Buchanan Notary Public.



15-163-20676-00-00

WELL LOG

OPERATOR: C-G DRILLING CO.

WELL NAME: SCHMIDT #1 LOCATION: NW SE SW

COUNTY: ROOKS STATE: KANSAS

WELL COMMENCED: 2/4/77 WELL COMPLETED: 2/9/77

ELEVATION: 2101 KB TOTAL DEPTH: 3325

PRODUCTION: DRY AND ABANDONED RIG NO: 1

CASING - 8-5/8": 6 JTS, 210.15 USED 28# W/140 SX COM + 2% GEL + 3% CA CL  
5-1/2":

ALL MEASUREMENTS TAKEN FROM THE TOP OF ROTARY BUSHING:

FROM	TO	FORMATION	DEVIATION FROM VERTICAL	REMARKS:
0	870	SHALE & SAND		
870	1070	SAND		
1070	1383	SHALE		
1383	1420	ANHYDRITE		
1420	1970	SHALE & SHELLS		
1970	3220	LIME & SHALE		
3220	3325	LIME		
	3325	RTD		

RECEIVED  
STATE CORPORATION COMMISSION  
FEB 22 1977  
02-22-1977  
CONSERVATION DIVISION  
Wichita, Kansas

STATE OF KANSAS )  
COUNTY OF SEDGWICK) SS:

The undersigned hereby certifies that to the best of his knowledge and belief, the above facts are true and correct.

C-G DRILLING CO.

By [Signature]

SUBSCRIBED AND SWORN TO, BEFORE ME, This 14th day of February, 1977.

MY COMM. EXP. DEC. 8, 1979

[Signature]  
PHYLLIS BUCHANAN - NOTARY PUBLIC

