

WELL PLUGGING RECORD

OR


FORMATION PLUGGING RECORD

Strike out upper line
when reporting plug-
ging off formations.

Give All Information Completely
Make Required Affidavit
Mail or Deliver Report to:
Conservation Division
State Corporation Commission
800 Bittling Building
Wichita, Kansas

Rooks County. Sec. 30 Twp. 10S Rge. (E) 17 (W)
Location as "NE 1/4 NW 1/4 SW 1/4" or footage from lines. 330' from N line & 990' from E line of SW 1/4
Lease Owner. Skelly Oil Company
Lease Name. Willie Gick Well No. 1
Office Address. Box 391, Hutchinson, Kansas
Character of Well (completed as Oil, Gas or Dry Hole) Dry Hole
Date well completed. November 9, 19 46
Application for plugging filed. November 11, 19 46
Application for plugging approved. November 13, 19 46
Plugging commenced. November 12, 19 46
Plugging completed. November 12, 19 46
Reason for abandonment of well or producing formation. Dry Hole

NORTH

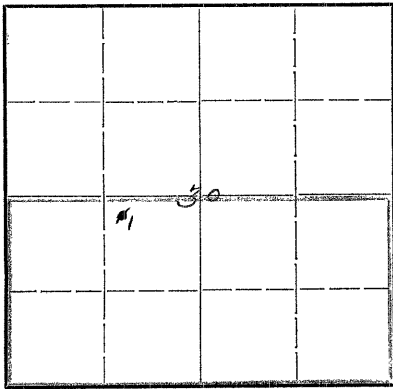

Locate well correctly on above
Section Plat

If a producing well is abandoned, date of last production. 19
Was permission obtained from the Conservation Division or its agents before plugging was com-
menced? Yes

Name of Conservation Agent who supervised plugging of this well. Mr. H. W. Kerr
Producing formation. Dry Hole Depth to top. Bottom. Total Depth of Well. 3710 Feet
Show depth and thickness of all water, oil and gas formations.

OIL, GAS OR WATER RECORDS


CASING RECORD

Formation	Content	From	To	Size	Put In	Pulled Out
Arbuckle Lime	Water	3694'	3710'	13"OD	182'6"	None
				8-5/8"OD	1348'6"	None

Describe in detail the manner in which the well was plugged, indicating where the mud fluid was placed and the method or methods used in introducing it into the hole. If cement or other plugs were used, state the character of same and depth placed, from feet to feet for each plug set.

35 sacks of cement 3710' to 3590'
Mud laden fluid 3590' to 300'
35 sacks of cement 300' to 195'
Mud laden fluid 195' to 90'
30 sacks of cement 90' to 6'
Surface soil 6' to 0'

PLUGGING
FILE 30 10 17W
PAGE 81 LINE 14

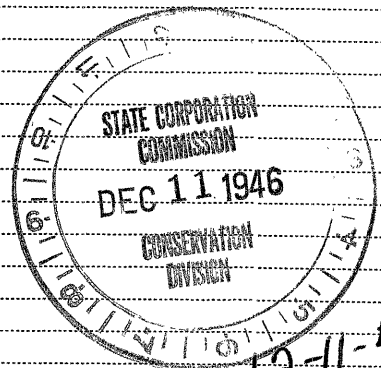

(If additional description is necessary, use BACK of this sheet)

Correspondence regarding this well should be addressed to. Skelly Oil Company,
Address. Box 391, Hutchinson, Kansas

STATE OF KANSAS, COUNTY OF RENO, SS.

H. E. Wamsley (employee of owner) or (owner) of the above-described well,
being first duly sworn on oath, says: That I have knowledge of the facts, statements, and matters herein contained and the log of the above-described well as filed and that the same are true and correct. So help me God.

(Signature)

Box 391, Hutchinson, Kansas
(Address)

SUBSCRIBED AND SWORN to before me this 10th day of December, 1946.

My commission expires April 7, 1947

Notary Public.

