


Give All Information Completely  
Make Required Affidavit  
Mail or Deliver Report to:  
Conservation Division  
State Corporation Commission  
211 No. Broadway  
Wichita, Kansas

WELL PLUGGING RECORD

NORTH

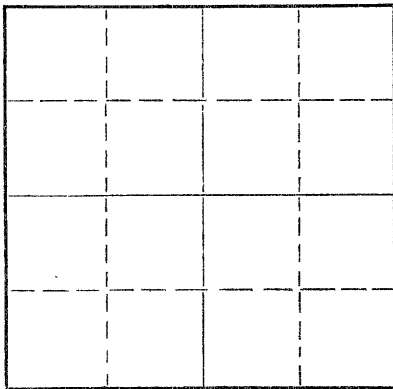

Locate well correctly on above  
Section Plat

Rooks County. Sec. 30 Twp. 10S Rge. 17 (EW) (W)  
Location as "NE/CNW/SW" or footage from lines 200' West of C NW SE  
Lease Owner Davis Bros. Transit Corporation  
Lease Name Garvert "D" Well No. 1  
Office Address 1516 Liberty Bank Bldg., Okla. City, Oklahoma  
Character of Well (completed as Oil, Gas or Dry Hole) D & A  
Date well completed October 23, 1958  
Application for plugging filed October 23, 1958  
Application for plugging approved October 23, 1958  
Plugging commenced October 23, 1958  
Plugging completed October 23, 1958  
Reason for abandonment of well or producing formation No Production

If a producing well is abandoned, date of last production \_\_\_\_\_ 19\_\_\_\_  
Was permission obtained from the Conservation Division or its agents before plugging was commenced? Yes

Name of Conservation Agent who supervised plugging of this well Eldon Petty, Box 326, Hays, Kansas  
Producing formation \_\_\_\_\_ Depth to top \_\_\_\_\_ Bottom \_\_\_\_\_ Total Depth of Well \_\_\_\_\_ Feet  
Show depth and thickness of all water, oil and gas formations.

OIL, GAS OR WATER RECORDS

CASING RECORD

FORMATION	CONTENT	FROM	TO	SIZE	PUT IN	PULLED OUT
				8 5/8"	175'	None

Describe in detail the manner in which the well was plugged, indicating where the mud fluid was placed and the method or methods used in introducing it into the hole. If cement or other plugs were used, state the character of same and depth placed, from \_\_\_\_\_ feet to \_\_\_\_\_ feet for each plug set.

Filled hole with heavy drilling mud to 550'; set plug, cemented with 20 sacks of cement  
Filled hole with heavy drilling mud to 170'; set plug, cemented with 1/2 sack hulls and 15 sacks cement  
Filled hole with heavy drilling mud to 40'; set plug, cemented with 1/2 sack hulls and 10 sacks cement

(If additional description is necessary, use BACK of this sheet)

Name of Plugging Contractor Transit Corporation  
Address 1516 Liberty Bank Building, Oklahoma City, Oklahoma

STATE OF Oklahoma, COUNTY OF Oklahoma, ss.  
Paul E. Gathers (employee of owner) or (owner or operator) of the above-described well, being first duly sworn on oath, says: That I have knowledge of the facts, statements, and matters herein contained and the log of the above-described well as filed and that the same are true and correct. So help me God.

(Signature) Paul E. Gathers

(Address) \_\_\_\_\_

SUBSCRIBED AND SWORN TO before me this 10th. day of November, 19 58

Mildred Sam

My commission expires May 17, 1962.

Notary Public  
Conservation Division

PLUGGING  
FILE SEC 30 T 10 R 17W  
BOOK PAGE 142 LINE 41

NOV 21 1958  
11-21-58  
CONSERVATION DIVISION  
Wichita, Kansas

DRILLER'S WELL LOG

Davis Bros.-Transit Corporation - Garvert "D" # 1 located in  
 200' West of C NW SE, Sec. 30-10S-17W  
 Rooks County, Kansas

Commenced: October 11, 1958  
 Completed: October 23, 1958  
 Elevation: 2050' KB

Casing 8 5/8" @ 175'  
 Cemented w/135 sacks

<u>Formation</u>	<u>From</u>	<u>To</u>	
Rock	0	80	
Shale	80	175	
Shale and shells	175	870	
Sand	870	1025	
Shale and shells	1025	1326	
Anhydrite	1326	1358	
Shale	1358	1855	
Lime and shale	1855	2650	
Shale and lime streaks	2650	2775	
Lime and shale	2775	2900	
Shale and lime streaks	2900	3075	
Shale and lime	3075	3140	
Lime and shale	3140	3168	
Lime	3168	3258	
Lime and shale	3258	3313	
Lime	3313	3452	
Lime and shale	3452	3497	
Lime	3497	3550	
Shale and lime	3550	3566	
Conglomerate and chert	3566	3642	
Lime	3642	3685 TD	

Summary of Formation

Anhydrite	1356'
Topeka	3026'
Heebner	3252'
Toronto	3270'
Lansing-KC	3293'
Base of KC	3534'
Conglomerate	3566'
Simpson Dolo.	3641'
Arbuckle	3660'

I hereby certify the foregoing to be a true and accurate Driller's Log of the formation encountered in the above well.

Subscribed and sworn to before me  
 this 10th. day of November, 1958.

TRANSIT CORPORATION

BY Paul E. Gathers

My Commission expires May 17, 1962.

Mildred Som  
 Notary Public

<b>PLUGGING</b>
FILE SEC. <u>30</u> T. <u>10</u> R. <u>17W</u>
BOOK PAGE <u>142</u> LINE <u>41</u>