


15-163-30221-00-00

WELL PLUGGING RECORD

Give All Information Completely
Make Required Affidavit
Mail or Deliver Report to:
Conservation Division
State Corporation Commission
211 No. Broadway
Wichita, Kansas

NORTH

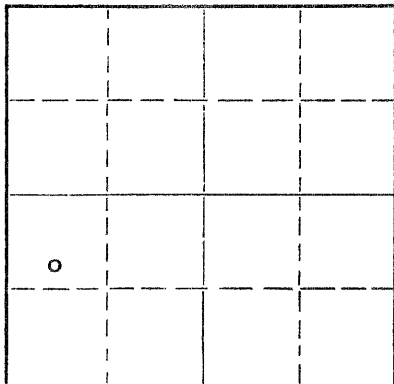

Locate well correctly on above
Section Plat

Rooks _____ County. Sec. 27 Twp. 10S Rge. 17W (E) _____ (W)
Location as "NE/CNW&SW&" or footage from lines CS/2 NW SW
Lease Owner Kern Drilling Company, Inc.
Lease Name Colby Well No. 1
Office Address 337 Union Center, Wichita, Kansas 67202
Character of Well (completed as Oil, Gas or Dry Hole) Dru Hole
Date well completed September 7 19 66
Application for plugging filed September 7 19 66
Application for plugging approved September 7 19 66
Plugging commenced September 7 19 66
Plugging completed September 7 19 66
Reason for abandonment of well or producing formation Dry Hole

If a producing well is abandoned, date of last production _____ 19 ____
Was permission obtained from the Conservation Division or its agents before plugging was commenced? Yes

Name of Conservation Agent who supervised plugging of this well Leo Massey, Box 582, Hays, Kansas
Producing formation _____ Depth to top _____ Bottom _____ Total Depth of Well 3598 Feet
Show depth and thickness of all water, oil and gas formations.

OIL, GAS OR WATER RECORDS

CASING RECORD

FORMATION	CONTENT	FROM	TO	SIZE	PUT IN	PULLED OUT
		0	207'	8 5/8"	207'	None

Describe in detail the manner in which the well was plugged, indicating where the mud fluid was placed and the method or methods used in introducing it into the hole. If cement or other plugs were used, state the character of same and depth placed, from _____ feet to _____ feet for each plug set.

Set Plug: 540' / 25 sacks cement & 1/2 sack hulls
200' / 20 sacks cement & 1/2 sack hulls
40' / 10 sacks cement & 1/2 sack hulls

SEP 16 1966
09-16-1966
CONSERVATION DIVISION
WICHITA, KANSAS

(If additional description is necessary, use BACK of this sheet)
Name of Plugging Contractor Hellar Drilling Company, Inc.
Address 1014 Union Center, Wichita, Kansas 67202

STATE OF Kansas, COUNTY OF Sedgwick, ss.
D. L. Hellar, President of Hellar Drilling Co. Inc. (employee of owner) or (owner or operator) of the above-described well, being first duly sworn on oath, says: That I have knowledge of the facts, statements, and matters herein contained and the log of the above-described well as filed and that the same are true and correct. So help me God.

(Signature) D. L. Hellar D. L. Hellar, President
1014 Union Center, Wichita, Kansas 67202
(Address)

SUBSCRIBED AND SWORN TO before me this 15th day of September, 19 66

My commission expires March 25, 1968.
Catherine Darcey Notary Public.

15-163-30221-00-00

DRILLER'S LOG

COMPANY: Kern Drilling Company, Inc., 337 Union Center, Wichita,
 CONTRACTOR: Hellar Drilling Company, Inc., Wichita, Kansas Kansas
 LEASE: #1 Colby
 LOCATION: CS/2 NW SW 27-10S-17W, Rooks County, Kansas
 COMMENCED: August 29, 1966
 COMPLETED: September 7, 1966
 CASING: Set 8 5/8" surface casing @ 207'/150 sacks cement

0-207	Shale
207-730	Shale-Shells-Sand
730-1223	Red Bed, Sand & Shale
1223-1266	Anhydrite
1266-1460	Shale
1460-1789	Salt Section
1789-2972	Lime & Shale
2972-3082	Lime
3082-3219	Lime & Shale
3219-3357	Lime
3357-3423	Lime & shale streaks
3423-3461	Lime & shale
3461-3468	Shale
3468-3542	Lime-Shale & chert Congl.
3542-3574	Chert
3574-3583	Lime
3583-3598	Dolomite
3598	Rotary Total Depth

D & A

RECEIVED
 STATE CORPORATION COMMISSION
 SEP 16 1966
 09-16-1966
 CONSERVATION DIVISION
 Wichita, Kansas

STATE OF KANSAS)
) SS
 COUNTY OF SEDGWICK)

I, D. L. Hellar, do hereby certify that the above and foregoing is a true and correct copy of the log of the #1 Colby, located in CS/2 NW SW Sec. 27-10S-17W, Rooks County, Kansas, as reflected by the files of the Hellar Drilling Company, Inc.

HELLAR DRILLING COMPANY, INC.

By *D. L. Hellar*
 President - D. L. Hellar

Subscribed and sworn to before me, a Notary Public, in and for Sedgwick County, Kansas, this 15th day of September, 1966.

Catherine Darcey
 Notary Public - Catherine Darcey

My Commission Expires:
 March 25, 1968.