


Give All Information Completely  
Make Required Affidavit  
Mail or Deliver Report to:  
Conservation Division  
State Corporation Commission  
211 No. Broadway  
Wichita, Kansas

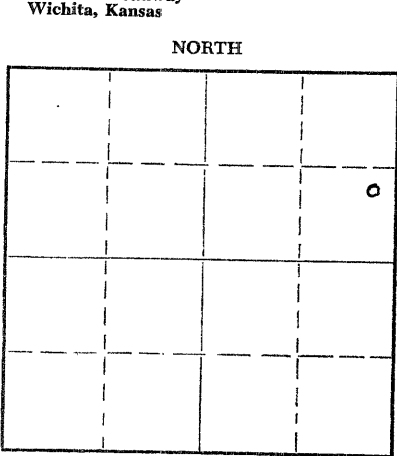

Locate well correctly on above Section Plat

Rooks County. Sec. 27 Twp. 10S Rge. 17W (E) (W)  
Location as "NE/CNW/SW" or footage from lines NE SE NE  
Lease Owner Anschutz Drilling Co., Inc.  
Lease Name Bice Well No. 1  
Office Address 709 Union Natl. Bldg., Wichita 2, Kansas  
Character of Well (completed as Oil, Gas or Dry Hole) Dry Hole  
Date well completed April 12 1957  
Application for plugging filed April 13 1957  
Application for plugging approved April 13 1957  
Plugging commenced April 13 1957  
Plugging completed April 13 1957  
Reason for abandonment of well or producing formation \_\_\_\_\_

If a producing well is abandoned, date of last production \_\_\_\_\_ 19\_\_\_\_  
Was permission obtained from the Conservation Division or its agents before plugging was commenced? Yes

Name of Conservation Agent who supervised plugging of this well Eldon Petty  
Producing formation \_\_\_\_\_ Depth to top \_\_\_\_\_ Bottom \_\_\_\_\_ Total Depth of Well 3725 Feet  
Show depth and thickness of all water, oil and gas formations.

OIL, GAS OR WATER RECORDS

CASING RECORD

FORMATION	CONTENT	FROM	TO	SIZE	PUT IN	PULLED OUT
				8-5/8"	192'	

Describe in detail the manner in which the well was plugged, indicating where the mud fluid was placed and the method or methods used in introducing it into the hole. If cement or other plugs were used, state the character of same and depth placed, from \_\_\_\_\_ feet to \_\_\_\_\_ feet for each plug set.

Pushed first plug down to 550' and dumped 25 sacks cement.  
Filled hole with heavy mud. Pushed second plug down to  
40' and dumped 10 sacks cement.

RECEIVED  
STATE CORPORATION COMMISSION  
04-19-1957  
APR 19 1957

CONSERVATION DIVISION  
Wichita, Kansas

(If additional description is necessary, use BACK of this sheet)  
Name of Plugging Contractor Anschutz Drilling Co., Inc.  
Address 709 Union Natl. Bldg., Wichita 2, Kansas

STATE OF Kansas, COUNTY OF Sedgwick, ss.  
Shirley Salley (employee of owner) or (owner or operator) of the above-described well, being first duly sworn on oath, says: That I have knowledge of the facts, statements, and matters herein contained and the log of the above-described well as filed and that the same are true and correct. So help me God.

(Signature) Shirley Salley Shirley Salley  
709 Union Natl. Bldg., Wichita, Kansas  
(Address)

SUBSCRIBED AND SWORN TO before me this 18th day of April, 19 57

My commission expires April 27, 1959  
Kenneth R. Swenson Notary Public.

PLUGGING  
FILE SEC. 27 T. 10 R. 17W  
BOOK PAGE 6 LINE 22

15-163-19323-00-00

DRILLERS' LOG

ANSCHUTZ DRILLING CO., INC. #1 BICE

NE SE NE Sec. 27-10S-17W  
Rooks County, Kansas

<u>FROM</u>	<u>TO</u>	
0	830	Shale
830	925	Dakota sand
925	1180	Sand
1180	1300	Sand and shale
1300	1350	Anhydrite
1350	1545	Shale and shells
1545	1820	Shale
1820	2300	Shale and lime
2300	2390	Lime
2390	2550	Lime and shale
2550	2755	Lime
2755	3205	Shale and lime
3205	3651	Lime
3651	3679	Simpson
3679	3725	Arbuckle shale
3725		Rotary Total Depth

COMMENCED: 3/22/57

COMPLETED: 4/13/57

CASING RECORD:  
Set 192' of 8-5/8" surface casing  
with 150 sacks cement, 100# calcium  
chloride, 2 plugs

**RECEIVED**  
STATE CORPORATION COMMISSION

STATE OF KANSAS )  
COUNTY OF SEDGWICK )

SS APR 19 1957  
04-19-1957  
CONSERVATION DIVISION  
Wichita, Kansas

I hereby affirm that the foregoing is a true and correct copy of the formations encountered on the #1 Bice, NE SE NE of Section 27-10S-17W, Rooks County, Kansas, as reflected by the daily drilling reports.

ANSCHUTZ DRILLING CO., INC.

By Shirley Salley  
Shirley Salley

Subscribed and sworn to before me this 18th day of April, 1957.

My commission expires April 27, 1959.

Kenneth R. Swenson  
Kenneth R. Swenson, Notary Public

**PLUGGING**  
FILE SEC. 27 T. 10 R. 17W  
BOOK PAGE 6 LINE 22