

15-163-20733-00-00

STATE OF KANSAS
STATE CORPORATION COMMISSION

Form CP-4


Give All Information Completely
Make Required Affidavit
Mail or Deliver Report to:
Conservation Division
State Corporation Commission
212 No. Market
Wichita, Kansas

WELL PLUGGING RECORD

Rooks County. Sec. 27 Twp. 10s Rge. (E) 17w(W)

Location as "NE/CNW/SW" or footage from lines NW-NW-SE
Lease Owner Rupe Oil Company, Inc.
Lease Name Bice Well No. 1
Office Address 434 Ohio Wichita, Kansas 67201
Character of Well (completed as Oil, Gas or Dry Hole) Dry hole
Date well completed Sept. 13 19 77
Application for plugging filed (oral) Sept. 13 19 77
Application for plugging approved Sept. 13 19 77
Plugging commenced Sept. 13 19 77
Plugging completed Sept. 13 19 77
Reason for abandonment of well or producing formation Dry hole

NORTH

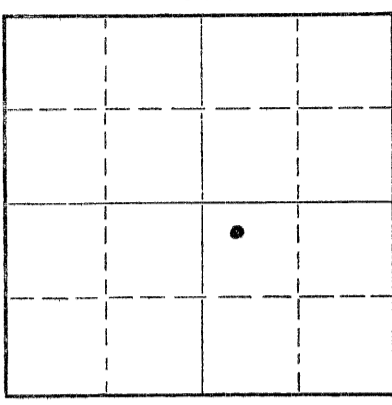

Locate well correctly on above Section Flat

If a producing well is abandoned, date of last production 19
Was permission obtained from the Conservation Division or its agents before plugging was commenced? Yes

Name of Conservation Agent who supervised plugging of this well Leo Massey
Producing formation Depth to top Bottom Total Depth of Well Feet
Show depth and thickness of all water, oil and gas formations.

OIL, GAS OR WATER RECORDS

CASING RECORD

FORMATION	CONTENT	FROM	TO	SIZE	PUT IN	PULLED OUT
Surface		0	215	8 5/8"		

Describe in detail the manner in which the well was plugged, indicating where the mud fluid was placed and the method or methods used in introducing it into the hole. If cement or other plugs were used, state the character of same and depth placed, from feet to feet for each plug set.

- 1st. Plug at 550' with 70 sacks cement 50-50 poz. 6% gel.
- 2nd. Plug at 185' with 20 sacks cement 50-50 poz. 6% gel.
- 3 rd. Plug at 40' with 10 sacks cement 50-50 poz. 6% gel.

09-23-1977


(If additional description is necessary, use BACK of this sheet)

Name of Plugging Contractor Halliburton Services
Address P.O. Box 339 Hays, Kansas 67601

STATE OF Kansas, COUNTY OF Graham, ss.
Jerry M. Helberg (employee of owner) or (owner or operator) of the above-described well, being first duly sworn on oath, says: That I have knowledge of the facts, statements, and matters herein contained and the log of the above-described well as filed and that the same are true and correct. So help me God.

(Signature) Jerry M. Helberg
Box 32 Morland, Kansas 67650
(Address)

SUBSCRIBED AND SWORN TO before me this 20th day of Sept., 1977

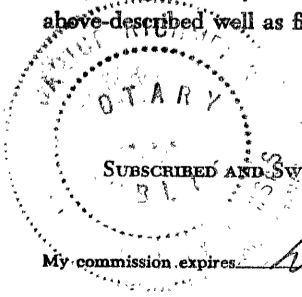

Janice Robinson Notary Public.

DRILLERS LOG

BICE #1

CASING RECORD:

8 5/8" set at 215'

TOTAL DEPTH:

3598'

DESCRIPTION:

NW NW SE
Sec. 27-10-17, Rooks County, Kansas

OPERATOR: Rupe Oil Company, Inc.

CONTRACTOR: Helberg Oil Co.

COMMENCED: September 2, 1977

COMPLETED: September 13, 1977

<u>FORMATION</u>	<u>FROM</u>	<u>TO</u>	<u>REMARKS</u>
Sand & Shale	0	40	
Sand & Shale	40	230	
Shale	230	637	
Sand & Shale	637	1195	
Shale	1195	1224	
Anhydrite	1224	1260	
Sand & Shale	1260	1380	
Shale	1380	1700	
Shale	1700	1945	
Shale	1945	2119	
Shale	2119	2205	
Shale	2205	2290	
Shale	2290	2416	
Shale	2416	2509	
Shale	2509	2609	
Shale	2609	2712	
Shale	2712	2814	
Shale	2814	2920	
Shale	2920	3018	
Shale	3018	3070	
Shale	3070	3130	
Shale	3130	3184	
Shale	3184	3240	
Shale	3240	3283	
Lime	3283	3315	
Lime	3315	3325	
Lime	3325	3382	
Lime	3382	3424	
Lime	3424	3475	
Lime	3475	3530	
Lime	3530	3580	
Lime	3580	3598	
T.D.	3598		D. & A.

I certify that this is a true and correct copy of the above log to the best of my knowledge.

HELBERG OIL COMPANY

Jerry M. Helberg
Jerry M. Helberg

Subscribed and sworn to before me this 20 day of September, 1977.

Faye E. Minium
Faye E. Minium, Notary Public

