


STATE OF KANSAS  
STATE CORPORATION COMMISSION

Give All Information Completely  
Make Required Affidavit  
Mail or Deliver Report to:  
Conservation Division  
State Corporation Commission  
800 Bittling Building  
Wichita, Kansas

NORTH

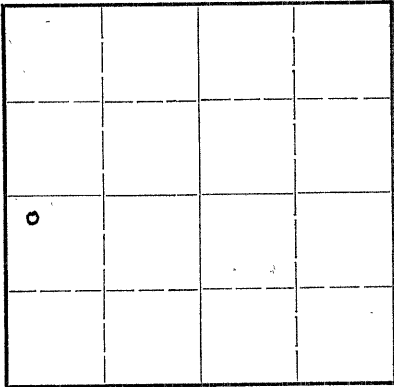

Locate well correctly on above  
Section Plat

Name of Conservation Agent who supervised plugging of this well H. W. Kerr  
Producing formation \_\_\_\_\_ Depth to top \_\_\_\_\_ Bottom \_\_\_\_\_ Total Depth of Well 3588 Feet  
Show depth and thickness of all water, oil and gas formations.

OIL, GAS OR WATER RECORDS

CASING RECORD

Formation	Content	From	To	Size	Put In	Pulled Out
Arbuckle Lime	Dry	3523	3588	None		None

Describe in detail the manner in which the well was plugged, indicating where the mud fluid was placed and the method or methods used in introducing it into the hold. If cement or other plugs were used, state the character of same and depth placed, from 200 feet to surface feet for each plug set.

15 sks cement in bottom of surface pipe(200)  
10 sks cement in top of surface pipe

(If additional description is necessary, use BACK of this sheet)

Correspondence regarding this well should be addressed to Goodpaster Drilling Company  
Address Box 518 Great Bend, Kansas

STATE OF (Barton) Kansas, COUNTY OF Barton, ss.  
Goodpaster Drilling Company, Contractor (employee of owner) or (owner or operator) of the above-described well,  
being first duly sworn on oath, says: That I have knowledge of the facts, statements, and matters herein contained and the log of the above-described well as filed and that the same are true and correct. So help me God.

(Signature) [Signature]  
Box 518 Great Bend, Kansas  
(Address)

SUBSCRIBED AND SWORN to before me this 24 day of June, 1946.

My commission expires March 6-1947

21-543-s 8-45-6M

[Signature]  
06-26-1946 Notary Public

15-163-00086-00-00

PAINT: Blue #1

LOCATION: NW SW 10-108-17W Rocks County, Kansas

ALERTED: 2056 D. F.

CEMENTED: June 6, 1946


C. H. HEDD: June 21, 1946

200' 8 5/8" surface pipe cemented to surface

200' to 550'	Shale
550' to 860'	Shale and Red Bed
860' to 1020'	Sand
1020' to 1230'	Sandy Shale
1230' to 1310'	Shale
1310' to 1355'	Anhydrite
1355' to 1360'	Shale
1360' to 1425'	Shale and Shells
1425' to 1600'	Red Bed and Shale
1600' to 2185'	Shale and Shells
2185' to 2250'	Lime and Shale
2250' to 2380'	Shale and Lime
2380' to 2535'	Lime
2535' to 2780'	Lime and Shale
2780' to 2830'	Shale
2830' to 2845'	Lime
2845' to 3100'	Lime and Shale
3100' to 3157'	Lime
3157' to 3240'	Lime
3240' to 3270'	Shale and Lime Cherty
3270' to 3430'	Lime
3430' to 3627'	Lime and Shale
3627' to 3668'	Lime
3668'	Total Depth--Plugged and Abandoned

WITNESSES )  
 ) 38  
NOTARY )

The Goodpastor Drilling Company, contractor, of the above described well, being first duly sworn on oath states that: I have knowledge of the facts, statements, and matters herein contained and the log of the above described well, as filed and that the same are true and correct. So help me God.

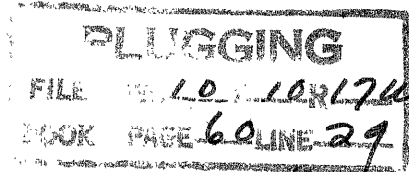

*Robert Goodpastor*  
Contractor

Subscribed and sworn to before me this 24 day of June 1946.

My Commission Expires:

March 6-1947

*R. C. Russell*  
Notary Public

