


WELL PLUGGING RECORD

Give All Information Completely
Make Required Affidavit
Mail or Deliver Report to:
Conservation Division
State Corporation Commission
800 Bittling Building
Wichita, Kansas

Rooks County. Sec. 13 Twp. 10 Rge. 17W (W)
Location as "NE/CNW/SW" or footage from lines SW SW NE
Lease Owner Murfin Drilling Co.
Lease Name Stevenson Well No. 1
Office Address 507 Union Nat. Bank Bldg - Wichita, Kansas
Character of Well (completed as Oil, Gas or Dry Hole) dry
Date well completed 12-13 19 55
Application for plugging filed 12-13 19 55
Application for plugging approved 12-13 19 55
Plugging commenced 12-13 19 55
Plugging completed 12-13 19 55
Reason for abandonment of well or producing formation dry

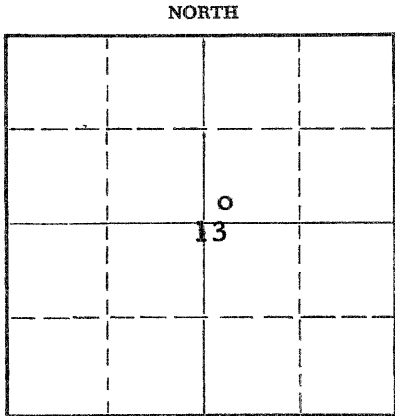

Locate well correctly on above Section Plat

If a producing well is abandoned, date of last production _____ 19____
Was permission obtained from the Conservation Division or its agents before plugging was commenced? yes

Name of Conservation Agent who supervised plugging of this well Eldon Petty
Producing formation _____ Depth to top _____ Bottom _____ Total Depth of Well 3623 Feet
Show depth and thickness of all water, oil and gas formations.

OIL, GAS OR WATER RECORDS

CASING RECORD

FORMATION	CONTENT	FROM	TO	SIZE	PUT IN	PULLED OUT
				8 5/8	186'	none

Describe in detail the manner in which the well was plugged, indicating where the mud fluid was placed and the method or methods used in introducing it into the hole. If cement or other plugs were used, state the character of same and depth placed, from _____ feet to _____ feet for each plug set.

Filled hole with mud laden fluid.
Set 1st plug at 180' w/1/2 sack hulls and 15 sacks cement.
Set 2nd plug at 40' w/1/2 sack hulls and 10 sacks cement.

(If additional description is necessary, use BACK of this sheet)

Name of Plugging Contractor Murfin Drilling Co.
Address 507 Union Nat. Bank Bldg - Wichita, Kansas

STATE OF Kansas, COUNTY OF Sedgwick, ss.
W. R. Murfin (employee of owner) or (owner or operator) of the above-described well, being first duly sworn on oath, says: That I have knowledge of the facts, statements, and matters herein contained and the log of the above-described well as filed and that the same are true and correct. So help me God.

(Signature) W. R. Murfin

(Address) _____, 19 56.

SUBSCRIBED AND SWORN TO before me this 6th day of January, 19 56.

My commission expires 6-13-59.

Betty Sprague Notary Public.
COMMISSION

PLUGGING
FILE SEC 13 T 10 R 17W
BOOK PAGE 26 LINE 10

JAN 12 1956
01-10-1956
CONSERVATION DIVISION
Wichita, Kansas

WELL LOG

15-163-00993-00-00

COMPANY **Murfin Drilling Co.**
 FARM **Stevenson** NO. **1**

SEC. **13** T. **10** R. **17W**
 LOC. **SW SW NE**

TOTAL DEPTH **3623**
 COMM. **12-2-55** COMP. **12-14-55**
 SHOT OR TREATED
 CONTRACTOR **Murfin Drilling Co.**
 ISSUED

COUNTY **Rooks**
 KANSAS

CASING

20	10	186' w/135 SX.
15	8	
12	6	
13	5	

ELEVATION **2049 DF**
 PRODUCTION **D & A**

FIGURES INDICATE BOTTOM OF FORMATIONS

55	Post Rock
160	Shale
473	Shale - Shells
530	Sand - Shale
600	Red Rock
830	Shale - Shells
960	Sand
1288	Red Bed
1323	Anhydrite
1575	Shale - Shells
3270	Shale - Lime
3367	Lime
3605	Lime - Shale
3623	Sand - Shale - Dolo.
3623	RTD

Tops:

Topeka	2983
Heebner	3208
Toronto	3233
Lansing	3253
White Chert	3577
Simpson	3588
RTD	3623

PLUGGING

FILE SEC 13 T. 10 R. 17W
 BOOK PAGE 26 LINE 10

RECEIVED
 01-10-1956
 DIVISION
 Wichita, Kansas

State of Kansas }
 County of Sedgwick } SS:

I, W. R. Murfin of the Murfin Drilling Company
 upon oath state that the above and foregoing is a true and correct copy of the log of the Stevenson #1 well.

W. R. Murfin

Subscribed and sworn to before me this 6th day of January 1956.

My Commission Expires: 6-13-59

Betty Spriggs
 NOTARY PUBLIC