


15-163-00899-00-00

WELL PLUGGING RECORD

Give All Information Completely  
Make Required Affidavit  
Mail or Deliver Report to:  
Conservation Division  
State Corporation Commission  
212 North Market, Insurance Bldg.  
Wichita, Kansas

Rooks County. Sec. 19 Twp 10S Rge. 17 (E) W (W)  
Location as "NE/CNW $\frac{1}{2}$ SW $\frac{1}{2}$ " or footage from lines 200' N 200' E C SE NW  
Lease Owner Davis Bros.-Transit Corporation  
Lease Name Befort "A" Well No. 1  
Office Address 1516 Liberty Bank Bldg., Oklahoma City, Oklahoma  
Character of Well (completed as Oil, Gas or Dry Hole) D & A  
Date well completed February 5, 1959  
Application for plugging filed February 5, 1959  
Application for plugging approved February 5, 1959  
Plugging commenced February 5, 1959  
Plugging completed February 5, 1959  
Reason for abandonment of well or producing formation No production

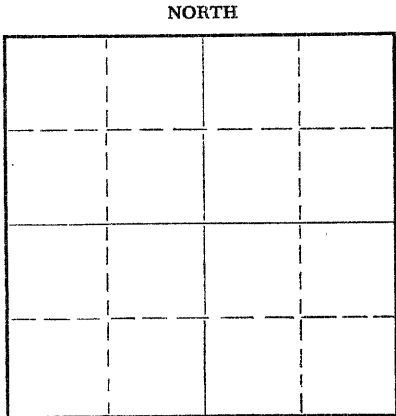

Locate well correctly on above Section Plat

If a producing well is abandoned, date of last production 19  
Was permission obtained from the Conservation Division or its agents before plugging was commenced? yes

Name of Conservation Agent who supervised plugging of this well Eldon Petty, Box 326, Hays, Kansas  
Producing formation \_\_\_\_\_ Depth to top \_\_\_\_\_ Bottom \_\_\_\_\_ Total Depth of Well \_\_\_\_\_ Feet  
Show depth and thickness of all water, oil and gas formations.

OIL, GAS OR WATER RECORDS

CASING RECORD

FORMATION	CONTENT	FROM	TO	SIZE	PUT IN	PULLED OUT
				8 5/8"	164'	None

Describe in detail the manner in which the well was plugged, indicating where the mud fluid was placed and the method or methods used in introducing it into the hole. If cement or other plugs were used, state the character of same and depth placed, from \_\_\_\_\_ feet to \_\_\_\_\_ feet for each plug set.

Filled hole with heavy drilling mud to 550', set plug, cemented with 20 sacks cement  
Filled hole with heavy drilling mud to 150', set plug, cemented with 15 sacks cement  
Filled hole with heavy drilling mud to 40', set plug, cemented with 10 sacks cement to bottom of cellar.

RECEIVED  
STATE CORPORATION COMMISSION  
MAR 9 1959  
CONSERVATION DIVISION  
WICHITA

(If additional description is necessary, use BACK of this sheet)  
Name of Plugging Contractor Transit Corporation  
Address 1516 Liberty Bank Building, Oklahoma City, Oklahoma

STATE OF Oklahoma, COUNTY OF Oklahoma, ss.  
Paul E. Gathers (employee of owner) or (owner or operator) of the above-described well, being first duly sworn on oath, says: That I have knowledge of the facts, statements, and matters herein contained and the log of the above-described well as filed and that the same are true and correct. So help me God.

(Signature) Paul E. Gathers

(Address) \_\_\_\_\_

SUBSCRIBED AND SWORN TO before me this March 5th day of March, 1959

Mildred Iron

My commission expires May 17, 1962

Notary Public.

PLUGGING  
FILE SEC. 19 T. 10 R. 17W  
BOOK PAGE 19 LINE 7

15-163-00899

DRILLER'S WELL LOG

Davis Bros. - Transit Corporation - Befort "A" # 1 well located in  
200'N 200'E C SE NW Sec. 19-10S-17W,  
Rooks County, Kansas

Commenced: January 23, 1959  
Completed: February 5, 1959  
Elevation: 2106 KB

Casing 8 5/8" @ 164'  
Cemented w/125 sacks

<u>Formation</u>	<u>From</u>	<u>To</u>
Surface clay	0	164
Shale and shells	164	705
Sand	705	850
Shale	850	900
Sand	900	1060
Shale and shells	1060	1396
Anhydrite	1396	1430
Shale and shells	1430	1920
Shale and lime	1920	2035
Lime and shale	2035	2200
Lime	2200	2315
Lime and shale streaks	2315	2410
Lime and shale	2410	2855
Shale w/lime streaks	2855	2958
Lime and shale	2958	2978
Shale	2978	2995
Shale w/lime streaks	2995	3125
Lime and shale	3125	3318
Lime	3318	3730 TD

Summary of Formation

Anhydrite	1396'
Topeka	3069'
Heebner	3291'
Toronto	3310'
Lansing	3335'
Base of K.C.	3577'
Conglomerate	3619'
Simpson	3681'
Arbuckle	3702'

I hereby certify the foregoing to be a true and accurate Driller's Log of the formation encountered in the above well.

Subscribed and sworn to before me  
this 6th. day of March, 1959.

TRANSIT CORPORATION

BY Paul E. Gathers

My Commission expires May 17, 1962.

Mildred From  
Notary Public

RECEIVED  
STATE OF KANSAS

MAR 9 1959  
03-09-1959  
CONSERVATION DIVISION  
Wichita, Kansas

PLUGGING  
FILE SEC. 19 T. 10 R. 17W  
BOOK PAGE 19 LINE 7