

For KCC Use: 10-29-07  
 Effective Date: 10-29-07  
 District #: 3  
 SGA?  Yes  No

KANSAS CORPORATION COMMISSION  
 OIL & GAS CONSERVATION DIVISION  
**NOTICE OF INTENT TO DRILL**

Form C-1  
 December 2002  
**Form must be Typed**  
**Form must be Signed**  
**All blanks must be Filled**

Must be approved by KCC five (5) days prior to commencing well

Expected Spud Date October 30, 2007  
 month day year

OPERATOR: License# 33344 ✓  
 Name: Quest Cherokee LLC  
 Address: 9520 North May Avenue, Suite 300  
 City/State/Zip: Oklahoma City, Oklahoma 73120  
 Contact Person: Richard Marlin  
 Phone: (405) 463-6880

CONTRACTOR: License# Will be licensed by the KCC ✓  
 Name: Will advise on the ACO-1

<b>Well Drilled For:</b>	<b>Well Class:</b>	<b>Type Equipment:</b>
<input type="checkbox"/> Oil	<input type="checkbox"/> Enh Rec	<input checked="" type="checkbox"/> Infield ✓
<input checked="" type="checkbox"/> Gas ✓	<input type="checkbox"/> Storage	<input type="checkbox"/> Pool Ext.
<input type="checkbox"/> OWWO	<input type="checkbox"/> Disposal	<input type="checkbox"/> Wildcat
<input type="checkbox"/> Seismic; # of Holes	<input type="checkbox"/> Other	<input type="checkbox"/> Cable
<input checked="" type="checkbox"/> Other: <u>Coalbed Methane</u>		

If OWWO: old well information as follows:  
 Operator: \_\_\_\_\_  
 Well Name: \_\_\_\_\_  
 Original Completion Date: \_\_\_\_\_ Original Total Depth: \_\_\_\_\_

Directional, Deviated or Horizontal wellbore?  Yes  No

If Yes, true vertical depth: \_\_\_\_\_

Bottom Hole Location: \_\_\_\_\_

KCC DKT #: \_\_\_\_\_

Spot S/2 SW NE Sec. 11 Twp. 28 S. R. 18  East  West  
2500 feet from  N /  S Line of Section  
1980 feet from  E /  W Line of Section  
 Is SECTION Regular  Irregular?

(Note: Locate well on the Section Plat on reverse side)

County: Neosho  
 Lease Name: Roecker, Matt W. Well #: 11-1  
 Field Name: Cherokee Basin CBM

Is this a Prorated / Spaced Field?  Yes  No

Target Formation(s): Cherokee Coals

Nearest Lease or unit boundary: 573 lease boundary

Ground Surface Elevation: 910 feet MSL

Water well within one-quarter mile:  Yes  No

Public water supply well within one mile:  Yes  No

Depth to bottom of fresh water: 100

Depth to bottom of usable water: 200-150

Surface Pipe by Alternate:  1  2

Length of Surface Pipe Planned to be set: 25

Length of Conductor Pipe required: \_\_\_\_\_

Projected Total Depth: 1300

Formation at Total Depth: Cherokee Coals

Water Source for Drilling Operations:  Well  Farm Pond Other Air

DWR Permit #: \_\_\_\_\_

(Note: Apply for Permit with DWR )

Will Cores be taken?  Yes  No

If Yes, proposed zone: \_\_\_\_\_

Lease boundary map attached.

**AFFIDAVIT**

The undersigned hereby affirms that the drilling, completion and eventual plugging of this well will comply with K.S.A. 55 et. seq.

It is agreed that the following minimum requirements will be met:

1. Notify the appropriate district office **prior** to spudding of well;
2. A copy of the approved notice of intent to drill **shall be** posted on each drilling rig;
3. The minimum amount of surface pipe as specified below **shall be set** by circulating cement to the top; in all cases surface pipe **shall be set** through all unconsolidated materials plus a minimum of 20 feet into the underlying formation.
4. If the well is dry hole, an agreement between the operator and the district office on plug length and placement is necessary **prior to plugging**;
5. The appropriate district office will be notified before well is either plugged or production casing is cemented in;
6. If an ALTERNATE II COMPLETION, production pipe shall be cemented from below any usable water to surface within **120 days** of spud date. Or pursuant to Appendix "B" - Eastern Kansas surface casing order #133,891-C, which applies to the KCC District 3 area, alternate II cementing must be completed within 30 days of the spud date or the well shall be plugged. **In all cases, NOTIFY district office** prior to any cementing.

I hereby certify that the statements made herein are true and to the best of my knowledge and belief.

Date: October 23, 2007 Signature of Operator or Agent: Richard Marlin Title: VP

RECEIVED  
 KANSAS CORPORATION COMMISSION  
 OCT 24 2007  
 CONSERVATION DIVISION  
 WICHITA, KS

**For KCC Use ONLY**  
 API # 15 - 133-27258-0000  
 Conductor pipe required None feet  
 Minimum surface pipe required 20 feet per Alt. **10**  
 Approved by: Put # 1024-07  
 This authorization expires: 4/24/08  
 (This authorization void if drilling not started within 6 months of approval date.)  
 Spud date: \_\_\_\_\_ Agent: \_\_\_\_\_

**Remember to:**

- File Drill Pit Application (form CDP-1) with Intent to Drill;
- File Completion Form ACO-1 within 120 days of spud date;
- File acreage attribution plat according to field proration orders;
- Notify appropriate district office 48 hours prior to workover or re-entry;
- Submit plugging report (CP-4) after plugging is completed;
- Obtain written approval before disposing or injecting salt water.
- If this permit has expired (See: authorized expiration date) please check the box below and return to the address below.

Well Not Drilled - Permit Expired

Signature of Operator or Agent: \_\_\_\_\_

Date: \_\_\_\_\_

Mail to: KCC - Conservation Division, 130 S. Market - Room 2078, Wichita, Kansas 67202

11  
28  
18E

**IN ALL CASES PLOT THE INTENDED WELL ON THE PLAT BELOW**

*Plat of acreage attributable to a well in a prorated or spaced field*

**If the intended well is in a prorated or spaced field, please fully complete this side of the form.** If the intended well is in a prorated or spaced field complete the plat below showing that the well will be properly located in relationship to other wells producing from the common source of supply. Please show all the wells and within 1 mile of the boundaries of the proposed acreage attribution unit for gas wells and within 1/2 mile of the boundaries of the proposed acreage attribution unit for oil wells.

API No. 15 - 133-272580000  
 Operator: Quest Cherokee LLC  
 Lease: Roecker, Matt W.  
 Well Number: 11-1  
 Field: Cherokee Basin CBM

Number of Acres attributable to well: \_\_\_\_\_  
 QTR / QTR / QTR of acreage: S/2 - SW - NE

Location of Well: County: Neosho  
 \_\_\_\_\_ feet from  N /  S Line of Section  
 \_\_\_\_\_ feet from  E /  W Line of Section  
 Sec. 11 Twp. 28 S. R. 18  East  West



Is Section:  Regular or  Irregular

**If Section is Irregular, locate well from nearest corner boundary.**

Section corner used:  NE  NW  SE  SW

**PLAT**

*(Show location of the well and shade attributable acreage for prorated or spaced wells.)  
 (Show footage to the nearest lease or unit boundary line.)*

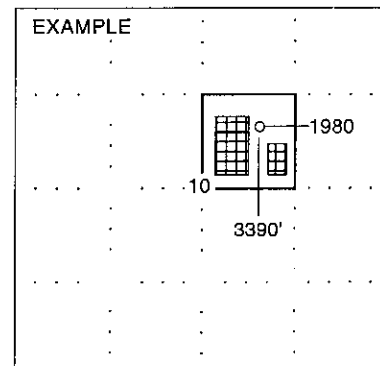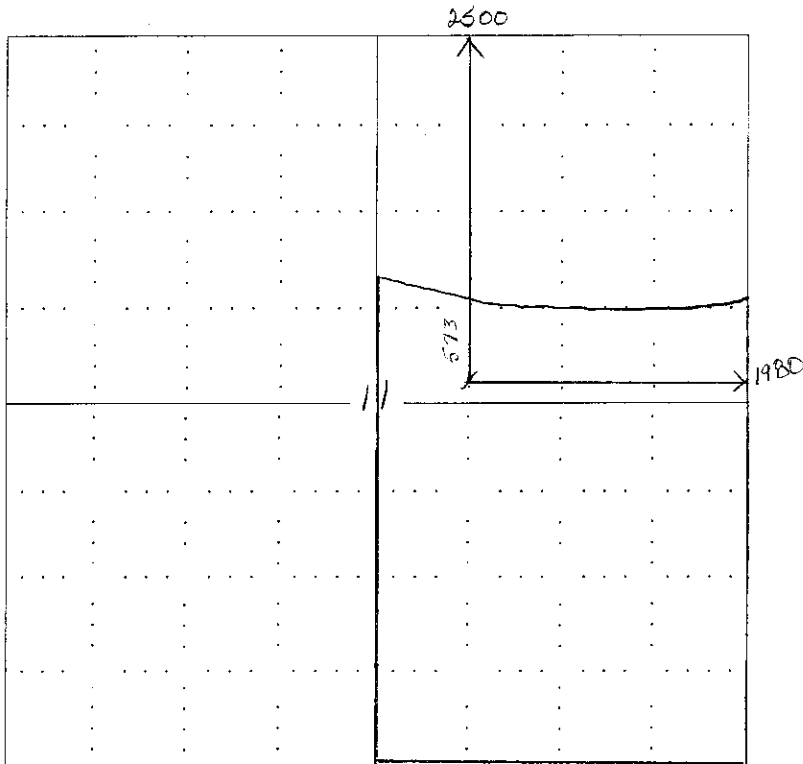

**NOTE: In all cases locate the spot of the proposed drilling location.**

**In plotting the proposed location of the well, you must show:**

1. The manner in which you are using the depicted plat by identifying section lines, i.e. 1 section, 1 section with 8 surrounding sections, 4 sections, etc.
2. The distance of the proposed drilling location from the section's south / north and east / west.
3. The distance to the nearest lease or unit boundary line.
4. If proposed location is located within a prorated or spaced field a certificate of acreage attribution plat must be attached: (CO-7 for oil wells; CG-8 for gas wells).

Nordmeyer, Ray V. 3-1  
RAY V NORDMEYER  
1233  
15-3000747-000  
3

TAYLOR FAMILY TRUST  
650  
15-3000189-002  
WAYNE L TAYLOR ET UX  
649  
15-3000189-001

MATTHEW D RICHARD ET UX RALEIGH O WICKER LIVING TRUST AGMT U/A/D  
1835  
15-3001302-000  
1770  
15-3001245-000  
MATTHEW & JENNIFER RICHARD  
101126  
15-4001190-000

2

1

MATTHEW & JENNIFER RICHARD  
101126  
15-4001190-000

15-133-27258-0000

LARRY INGRAHAM FAMILY TRUST  
100271  
15-4000450-000  
GARY D SMITH  
1265  
15-3000779-000

LARRY W & LARRY L INGRAHAM, MARY L BEALE  
100170  
15-4000454-000

MATTHEW D RICHARD ET UX  
1834  
15-3001301-000

TERRY F. & TAMARA J. TAYLOR, H/W  
1976  
15-4000026-000

2930 FNL  
1980 FEL

JOHN STEWART ET UX  
1160  
15-3000680-000

HAROLD LIGHTWINE, ET UX  
773  
15-3000299-000

RONALD L. KING  
775  
15-3000301-000

MATT W ROECKER ET UX  
1259  
15-3000773-000

MARK E NEELY ET UX  
513  
15-3000061-000

MATT W ROECKER ET UX MATT W & LILA S. ROECKER  
100312  
15-3000773-000 15-4000468-000

12

10

28S-18E

Neosho

Lot 7  
Roecker, Matt W.

Lot 7

11-1

MATT W ROECKER ET UX  
1259  
15-3000773-000

MARK E NEELY ET UX  
513  
15-3000061-000

WILLIAM A STICH ET UX  
485  
15-3000033-000

RONALD L. KING  
775  
15-3000301-000

MATT W. & LILA S. ROECKER  
100312  
15-4000468-000

MATT W ROECKER ET UX  
1259  
15-3000773-000

Stich, William A. 10-1

HAROLD LIGHTWINE, ET UX  
773  
15-3000299-000  
LARRY W. AND CATHY MIH TAYLOR  
2226  
15-4000281-000

ANTHONY J BOLLIG ET UX  
599  
15-3000141-000

SHIRLEY SCHULTZ  
2236  
15-4000291-000

TRIPLE C, INC Triple 'C' 14-1  
2255  
15-4000310-000

HAROLD LIGHTWINE, ET UX  
773  
15-3000299-000

15

14

13

LARRY W TAYLOR ET UX ET AL  
700  
15-3000231-000

Triple 'C' 14-2 BRENDA RAY ET VIR  
517  
15-3000064-002

TRIPLE "C" INC  
644  
15-3000185-000

BARBARA BLASCHKE ET VIR  
516  
15-3000064-001

BARBARA BLASCHKE ET VIR  
516  
15-3000064-001

BARBARA BLASCHKE ET VIR  
516  
15-3000064-001

MERLE C. & LAURILLA TENNIS  
100144  
15-4000408-000

LLOYD D MOORE  
507  
15-3000055-000

MARION BAILEY ET UX  
1095  
15-3000616-000


BRENDA RAY ET VIR  
517  
15-3000064-002

BRENDA RAY ET VIR  
517  
15-3000064-002

**KANSAS CORPORATION COMMISSION  
OIL & GAS CONSERVATION DIVISION  
APPLICATION FOR SURFACE PIT**

Form CDP-1  
April 2004  
Form must be Typed

*Submit in Duplicate*

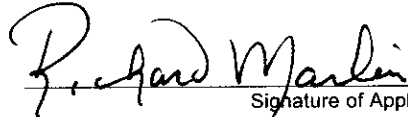Operator Name: <b>Quest Cherokee LLC</b>		License Number: <b>33344</b>
Operator Address: <b>9520 North May Avenue, Suite 300 Oklahoma City, Oklahoma 73120</b>		
Contact Person: <b>Richard Marlin</b>		Phone Number: ( <b>405</b> ) <b>463 - 6880</b>
Lease Name & Well No.: <b>Roecker, Matt W. #11-1</b>		Pit Location (QQQQ): <u>      </u> <u>      </u> <u>      </u> <u>      </u> <b>S/2 SW NE</b>
Type of Pit: <input type="checkbox"/> Emergency Pit <input type="checkbox"/> Burn Pit <input type="checkbox"/> Settling Pit <input checked="" type="checkbox"/> Drilling Pit <input type="checkbox"/> Workover Pit <input type="checkbox"/> Haul-Off Pit <small>(If WP Supply API No. or Year Drilled)</small>	Pit is: <input checked="" type="checkbox"/> Proposed <input type="checkbox"/> Existing If Existing, date constructed: _____ Pit capacity: <b>300</b> (bbls)	Sec. <b>11</b> Twp. <b>28</b> R. <b>18</b> <input checked="" type="checkbox"/> East <input type="checkbox"/> West <b>2500</b> Feet from <input checked="" type="checkbox"/> North / <input type="checkbox"/> South Line of Section <b>1980</b> Feet from <input checked="" type="checkbox"/> East / <input type="checkbox"/> West Line of Section <b>Neosho</b> _____ County
Is the pit located in a Sensitive Ground Water Area? <input checked="" type="checkbox"/> Yes <input type="checkbox"/> No		Chloride concentration: _____ mg/l <small>(For Emergency Pits and Settling Pits only)</small>
Is the bottom below ground level? <input type="checkbox"/> Yes <input checked="" type="checkbox"/> No	Artificial Liner? <input type="checkbox"/> Yes <input checked="" type="checkbox"/> No	How is the pit lined if a plastic liner is not used?
Pit dimensions (all but working pits): <u>      </u> <u>      </u> <u>      </u> Length (feet) <u>      </u> <u>      </u> Width (feet) <b>N/A: Steel Pits</b> Depth from ground level to deepest point: <u>      </u> (feet)		
If the pit is lined give a brief description of the liner material, thickness and installation procedure.		Describe procedures for periodic maintenance and determining liner integrity, including any special monitoring. <b>Air Drilling Operation lasting approx 3 days</b>
Distance to nearest water well within one-mile of pit <u>      </u> <b>N/A</b> feet    Depth of water well _____ feet	Depth to shallowest fresh water _____ feet. Source of information: _____ measured    _____ well owner    _____ electric log    _____ KDWR	
<b>Emergency, Settling and Burn Pits ONLY:</b> Producing Formation: _____ Number of producing wells on lease: _____ Barrels of fluid produced daily: _____ Does the slope from the tank battery allow all spilled fluids to flow into the pit? <input type="checkbox"/> Yes <input type="checkbox"/> No	<b>Drilling, Workover and Haul-Off Pits ONLY:</b> Type of material utilized in drilling/workover: <u>      </u> <b>Air Drilled</b> Number of working pits to be utilized: <u>      </u> <b>One</b> Abandonment procedure: <u>      </u> <b>Air Dry, Back Fill and Cover</b>  Drill pits must be closed within 365 days of spud date. <b>RECEIVED</b> KANSAS CORPORATION COMMISSION	
I hereby certify that the above statements are true and correct to the best of my knowledge and belief.		
October 23, 2007 Date	 Signature of Applicant or Agent	<b>OCT 24 2007</b> CONSERVATION DIVISION WICHITA, KS

15-135-27258-0000

<b>KCC OFFICE USE ONLY</b>			
Date Received: <u>      </u> <b>10/24/07</b>	Permit Number: _____	Permit Date: <u>      </u> <b>10/24/07</b>	Lease Inspection: <input type="checkbox"/> Yes <input checked="" type="checkbox"/> No

Mail to: KCC - Conservation Division, 130 S. Market - Room 2078, Wichita, Kansas 67202