

WELL PLUGGING APPLICATION

AUG 13 2007

This Form must be Typed
Form must be Signed
All blanks must be Filled

Please TYPE Form and File ONE Copy

LEGAL SECTION

API # 15 - 175-10186-00-00 (Identifier Number of this well). This must be listed for wells drilled since 1967; if no API # was issued,

indicate original spud or completion date Spud 6/27/60

Well Operator: Pardee Production Co. KCC License #: 31361

Address: 1658 Santa Cruz Drive City: Skiatook

State: OK Zip Code: 74070 Contact Phone: (918) 396 - 9200

Lease: Light Heirs Well #: 1-A Sec. 5 Twp. 35S S. R. 32 East West

SW SE Spot Location / QQQQ County: Seward

735' Feet (in exact footage) From North / South (from nearest outside section corner) Line of Section (Not Lease Line)

1,980' Feet (in exact footage) From East / West (from nearest outside section corner) Line of Section (Not Lease Line)

Check One: Oil Well Gas Well D&A Cathodic Water Supply Well
 SWD Docket # _____ ENHR Docket # _____ Other: _____

Conductor Casing Size: 21" Set at: 40' Cemented with: 27 Sacks

Surface Casing Size: 8-5/8" Set at: 2,189' Cemented with: 650 Sacks

Production Casing Size: 2-7/8" Set at: 6,238' Cemented with: 300 Sacks

List (ALL) Perforations and Bridgeplug Sets: Morrow 6,052'-6,058', Chester 6,168'-6,178'


Elevation: 2,751' (G.L. / K.B.) T.D.: 6,190' PBTD: _____ Anhydrite Depth: TOP ABOVE 2190' BASE 2635'
(Stone Corral Formation)

Condition of Well: Good Poor Casing Leak Junk in Hole

Proposed Method of Plugging (attach a separate page if additional space is needed): See Wellbore sketch attached

Is Well Log attached to this application as required? Yes No Is ACO-1 filed? Yes No

If not explain why? _____

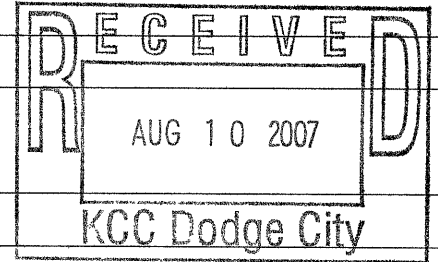

Plugging of this Well will be done in accordance with K.S.A. 55-101 et. seq. and the Rules and Regulations of the State Corporation Commission.

List Name of Company Representative authorized to be in charge of plugging operations: Jim Pardee

Phone: (918) 396 - 9200

Address: 11658 Santa Cruz Drive City / State: Skiatook, OK 74070

Plugging Contractor: Dollar well Service KCC License #: 33311
(Company Name) (Contractor's)

Address: Perryton, Texas Phone: () -

Proposed Date and Hour of Plugging (if known?): _____

Payment of the Plugging Fee (K.A.R. 82-3-118) will be guaranteed by Operator or Agent

Date: 8/17/07 Authorized Operator / Agent: James Z Pardee, PRESIDENT
(Signature)

KANSAS CORPORATION COMMISSION
OIL & GAS CONSERVATION DIVISION

WELL PLUGGING APPLICATION

Please TYPE Form and File ONE Copy

Form CP-1
September 2003
This Form must be Typed
Form must be Signed
All blanks must be Filled

API # 15 - 175-10186-00-00 (Identifier Number of this well). This must be listed for wells drilled since 1967; if no API # was issued,

indicate original spud or completion date Spud 6/27/60

Well Operator: Pardee Production Co. KCC License #: 31361

Address: 1658 Santa Cruz Drive City: Skiatook

State: OK Zip Code: 74070 Contact Phone: (918) 396 - 9200

Lease: Light Heirs Well #: 1-A Sec. 5 Twp. 35S S. R. 32 East West

Spot Location / QQQQ County: Seward

735' Feet (in exact footage) From North / South (from nearest outside section corner) Line of Section (Not Lease Line)

1,980' Feet (in exact footage) From East / West (from nearest outside section corner) Line of Section (Not Lease Line)

Check One: Oil Well Gas Well D&A Cathodic Water Supply Well
 SWD Docket # _____ ENHR Docket # _____ Other: _____

Conductor Casing Size: 21" Set at: 40' Cemented with: 27 Sacks

Surface Casing Size: 8-5/8" Set at: 2,189' Cemented with: 650 Sacks

Production Casing Size: 2-7/8" Set at: 6,238' Cemented with: 300 Sacks

List (ALL) Perforations and Bridgeplug Sets: Morrow 6,052'-6,058', Chester 6,168'-6,178'

Elevation: 2,751' (G.L. / K.B.) T.D.: 6,190' PBTD: _____ Anhydrite Depth: 2420 - BASE
(Stone Corral Formation)

Condition of Well: Good Poor Casing Leak Junk in Hole

Proposed Method of Plugging (attach a separate page if additional space is needed): See Wellbore sketch attached

Is Well Log attached to this application as required? Yes No Is ACO-1 filed? Yes No

If not explain why? _____

RECEIVED
KANSAS CORPORATION COMMISSION

AUG 27 2007

CONSERVATION DIVISION
WICHITA, KS

Plugging of this Well will be done in accordance with K.S.A. 55-101 et. seq. and the Rules and Regulations of the State Corporation Commission.

List Name of Company Representative authorized to be in charge of plugging operations: Jim Pardee

Phone: (918) 396 - 9200

Address: 11658 Santa Cruz Drive City / State: Skiatook, OK 74070

Plugging Contractor: Dollar well Service KCC License #: _____
(Company Name) (Contractor's)

Address: Perryton, Texas Phone: (806) 435 - 3373

Proposed Date and Hour of Plugging (if known?): _____

Payment of the Plugging Fee (K.A.R. 82-3-118) will be guaranteed by Operator or Agent

Date: 8/7/07 Authorized Operator / Agent: James Pardee
(Signature)

Mail to: KCC - Conservation Division, 130 S. Market - Room 2078, Wichita, Kansas 67202


LIGHT HEIRS #1A
SW/SE SEC 5-353-32W
SEWARD Co, KS

RECEIVED
KANSAS CORPORATION COMMISSION

4700' ±

AUG 13 2007

LEGAL SECTION

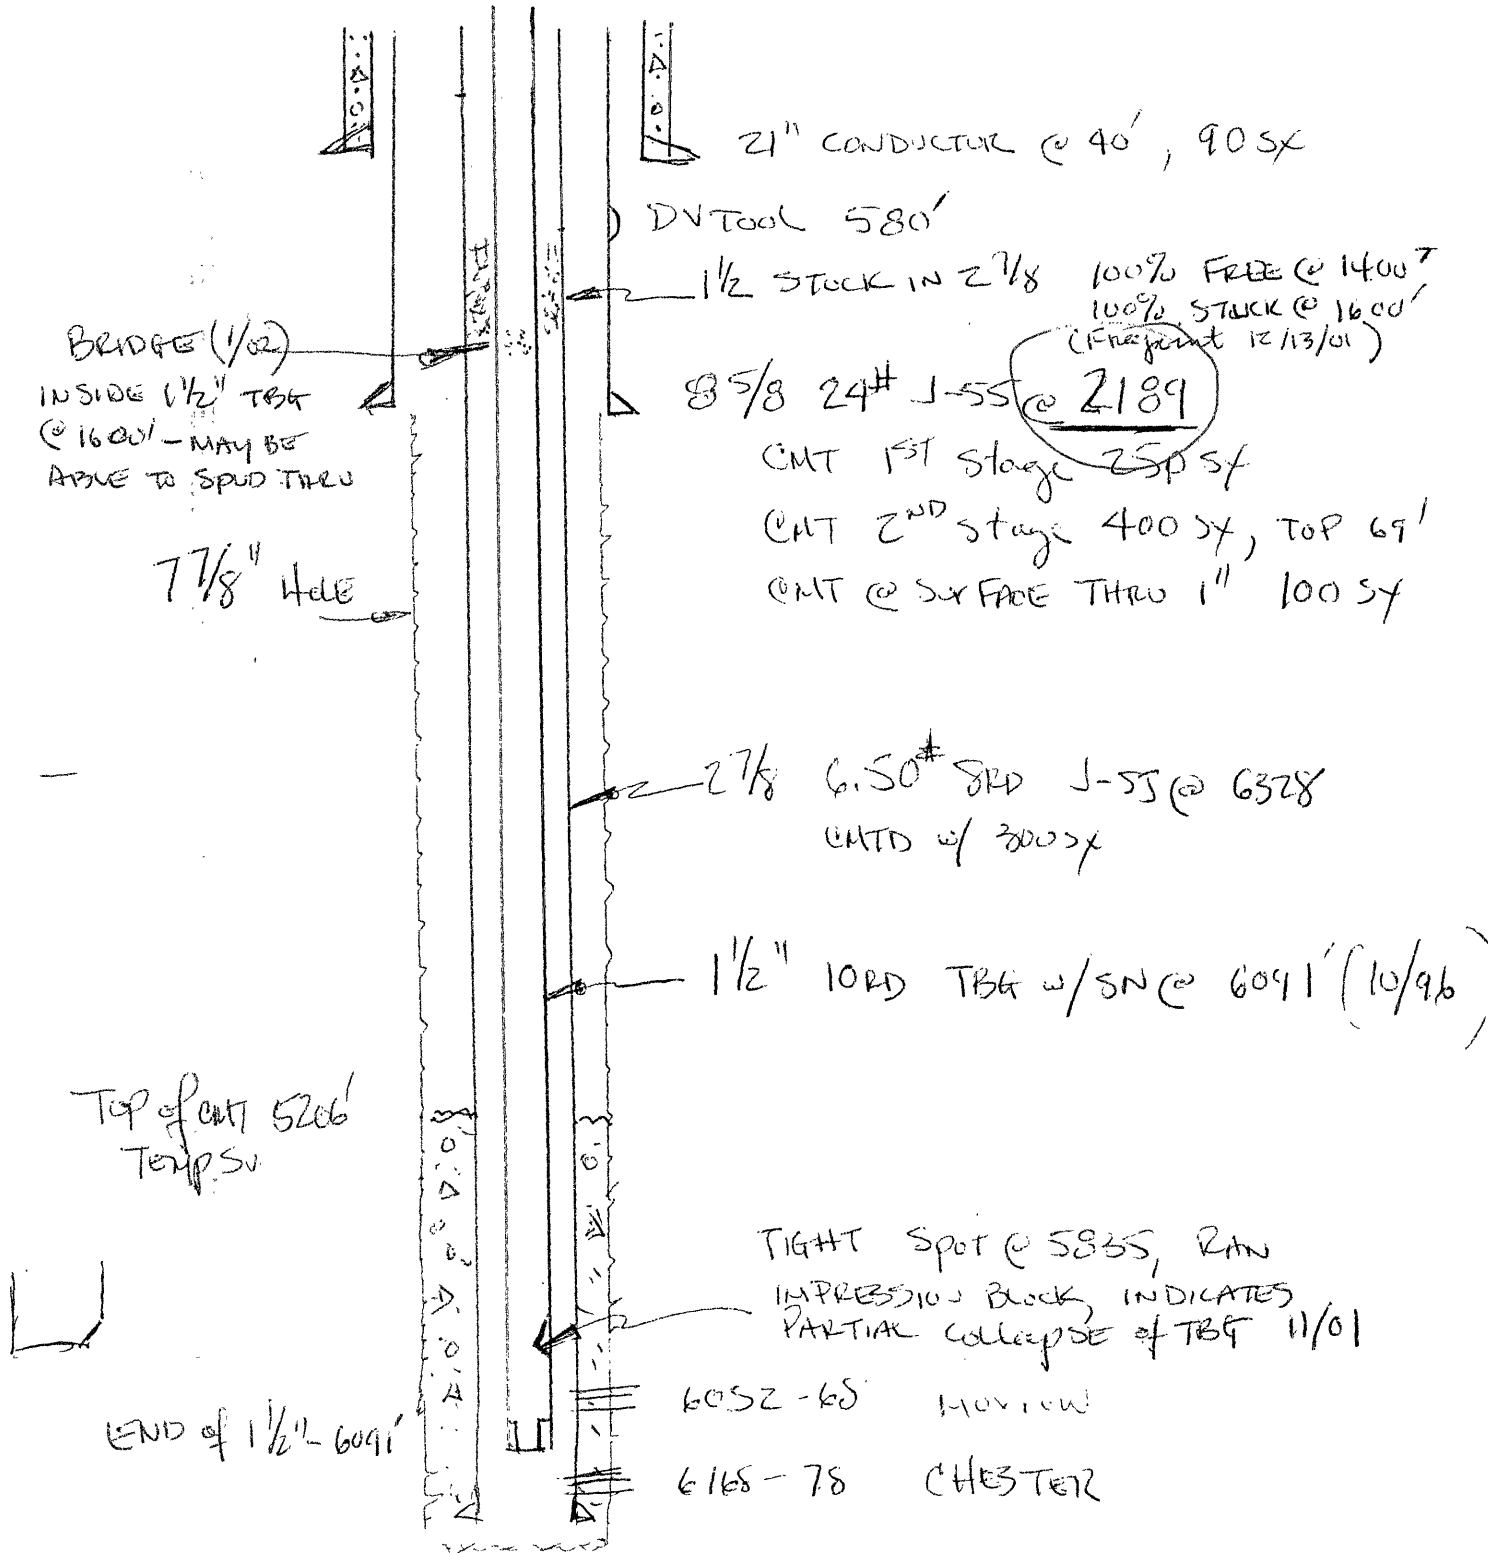



CORPORATION COMMISSION

Kathleen Sebelius, Governor Thomas E. Wright, Chairman Michael C. Moffet, Commissioner Joseph F. Harkins, Commissioner

NOTICE OF RECEIPT OF WELL PLUGGING APPLICATION (CP-1)

PARDEE PRODUCTION CO.
11658 SANTA CRUZ DRIVE
SKIATOOK, OK 74070

August 30, 2007

Re: LIGHT HEIRS #1-A
API 15-175-10186-00-00
5-35S-32W, 735 FSL 1980 FEL
SEWARD COUNTY, KANSAS

Dear Operator:

This letter is to notify you that the Conservation Division has received your plugging proposal, form CP-1, for the above well and has reviewed the proposal for completeness. The central office will now forward your CP-1 to the district office listed below for review of the proposed plugging method. **Please contact the district office for approval of your proposed plugging method at least five (5) days before plugging the well, pursuant to K.A.R. 82-3-113(b). If a workover pit will be used during the plugging of the well it must be permitted. A CDP-1 form must be filed and approved prior to the use of the pit in accordance with K.A.R. 82-3-600.**

The Conservation Division's review of form CP-1, either in the central or district office, does not include an inquiry into well ownership or the filing operator's legal right to plug the well. This notice in no way constitutes authorization to plug the above well by persons not having legal rights of ownership or interest in the well.

This notice is void after February 26, 2008. The CP-1 filing does not bring the above well into compliance with K.A.R. 82-3-111 with regard to the Commission's temporary abandonment requirements.

Sincerely,

Steve Bond
Production Department Supervisor

District: #1
210 E Frontview, Suite A
Dodge City, KS 67801
(620) 225-8888