

KANSAS CORPORATION COMMISSION
OIL & GAS CONSERVATION DIVISION
WELL PLUGGING APPLICATION
Please TYPE Form and File ONE Copy

Form CP-1
September 2003
This Form must be Typed
Form must be Signed
All blanks must be Filled

API # 15 - 185-13132 -00-01 (Identifier Number of this well). This must be listed for wells drilled since 1967; if no API # was issued,

indicate original spud or completion date 10-22-1958

Well Operator: W. D. Short Oil Co., LLC KCC License #: 33608

Address: P.O. Box 729, 102 S. River Rd. City: Oxford

State: Kansas Zip Code: 67119 Contact Phone: (620) 455 - 3576

Lease: N. Leesburg Unit Well #: 204 Sec. 12 Twp. 25S S. R. 13 East West

C - NE - SW - NE Spot Location / QQQQ County: Stafford

1800 Feet (in exact footage) From North / South (from nearest outside section corner) Line of Section (Not Lease Line)

1800 Feet (in exact footage) From East / West (from nearest outside section corner) Line of Section (Not Lease Line)

Check One: Oil Well Gas Well D&A Cathodic Water Supply Well
 SWD Docket # _____ ENHR Docket # _____ Other: _____

Conductor Casing Size: _____ Set at: _____ Cemented with: _____ Sacks

Surface Casing Size: 10-3/4" Set at: 254 Cemented with: 225 Sacks

Production Casing Size: 7" Set at: 4219 Cemented with: 250 Sacks

List (ALL) Perforations and Bridgeplug Sets: Perfs: 3624-29, 3708-16, 3724-33, 3755-62 CIBP @ 3770', 4175'

Elevation: 1920 (G.L. / K.B.) T.D.: 4221 PBDT: 3770 Anhydrite Depth: 738-58'
(Stone Corral Formation)

Condition of Well: Good Poor Casing Leak Junk in Hole

Proposed Method of Plugging (attach a separate page if additional space is needed): Per KCC Instructions

RECEIVED
KANSAS CORPORATION COMMISSION

AUG 23 2007

Is Well Log attached to this application as required? Yes No Is ACO-1 filed? Yes No

CONSERVATION DIVISION
WICHITA, KS

If not explain why? _____

Plugging of this Well will be done in accordance with K.S.A. 55-101 et. seq. and the Rules and Regulations of the State Corporation Commission.

List Name of Company Representative authorized to be in charge of plugging operations: Mike Anstine

Phone: (620) 218 - 1822

Address: P.O. Box 729, 102 S. River Rd. City / State: Oxford, Kansas 67119

Plugging Contractor: Mike's Testing & Salvage KCC License #: 31529

Address: P.O.Box 467 Chase, Ks. 67524 Phone: (620) 938 - 2943

Proposed Date and Hour of Plugging (if known?): ASAP

Payment of the Plugging Fee (K.A.R. 82-3-118) will be guaranteed by Operator or Agent
Date: 8-21-2007 Authorized Operator / Agent: [Signature] (Signature)

Mail to: KCC - Conservation Division, 130 S. Market - Room 2078, Wichita, Kansas 67202

S. W. McCUNE NO. 4
 1800'N 1800'E - Sec. 12-25S-12W
 Stafford County, Kansas

WELL RECORD

Operator: Continental Oil Company
 Ponca City, Oklahoma
 Contractor: Lohmann-Johnson Drilling Co., Inc.
 320 Indiana Bank Building, Evansville, Indiana
 Commenced: October 22, 1958
 Completed: November 10, 1958
 Casing: Ran 8 Jts. 10-3/4" Surface Casing set at 254' w/225 Sacks
 Ran 133 Jts. 7" Casing set at 4219-1/2' w/250 Sacks


FROM	TO	FORMATION
0	40	Sand
40	254	Sand & Shells
254	495	Shale
495	1370	Shale, Sand & Shells
1370	1590	Shale & Shells
1590	1679	Broken Lime
1679	1905	Lime
1905	2048	Shale & Lime
2048	2450	Lime
2450	2585	Lime & Shale
2585	2880	Shale
2880	3015	Shale & Lime Streaks
3015	3152	Lime & Shale
3152	3299	Lime
3299	3473	Lime & Shale
3473	3675	Lime
3675	3721	Core #1 - 46'
3721	3760	Core #2 - 39'
3760	3785	Core #3 - 25'
3785	4221	Lime
4221		TOTAL DEPTH

Ground Level Elevation - 1915'

RECEIVED
 KANSAS CORPORATION COMMISSION

AUG 23 2007

CONSERVATION DIVISION
 WICHITA, KS

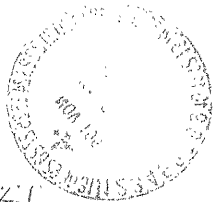

56-1
 DWM P-16 File

Spudded
10-22-58

7" - #20 pound casing →

N. Leesburg
204
(machine # 4)

32.75

10 3/4" surface at 25.
with 225 sxs.

334' } Hole Found &
0 } squeezed
428' } 10-18-04

3-26-92 - 124 J+s.
in Hole 3,720'

2675' top of cement

RECEIVED
KANSAS CORPORATION COMMISSION

AUG 23 2007

CONSERVATION DIVISION
WICHITA, KS

Perfs - L.K.C. -

F. Zone 3624' - 29'

I. Zone 3708' - 16'

J. Zone 3724' - 33'

K. Zone 3755' - 62'

~~Viola - 3940' - 46'~~

~~Simpson 4034' - 46'~~


~~Arbuckle - 4080' - 86'~~

~~Arbuckle - 4119' - 23'~~

~~Arbuckle - 4136' - 40'~~

plug back to 4175'

6-27-64 plug back
to 3770'

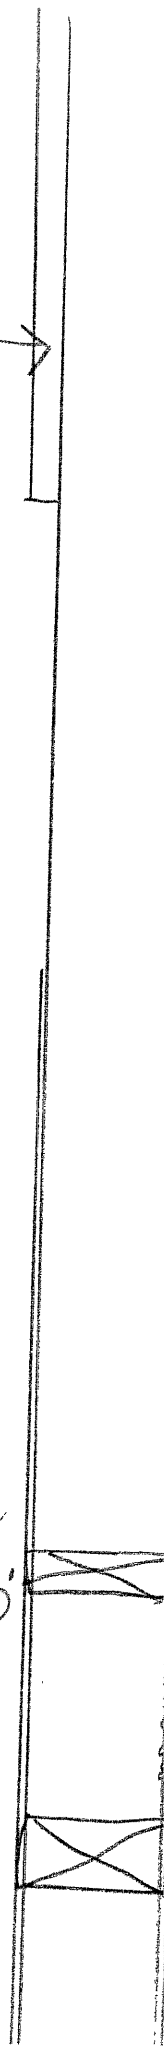



CORPORATION COMMISSION

Kathleen Sebelius, Governor Thomas E. Wright, Chairman Michael C. Moffet, Commissioner Joseph F. Harkins, Commissioner

NOTICE OF RECEIPT OF WELL PLUGGING APPLICATION (CP-1)

W.D. SHORT OIL CO., LLC
102 S. RIVER ROAD
PO BOX 729
OXFORD, KS 67119

August 29, 2007

Re: N. LEESBURG UNIT #204
API 15-185-13132-00-01
12-25S-13W, 1800 FNL 1800 FEL
STAFFORD COUNTY, KANSAS

Dear Operator:

This letter is to notify you that the Conservation Division has received your plugging proposal, form CP-1, for the above well and has reviewed the proposal for completeness. The central office will now forward your CP-1 to the district office listed below for review of the proposed plugging method. **Please contact the district office for approval of your proposed plugging method at least five (5) days before plugging the well, pursuant to K.A.R. 82-3-113(b). If a workover pit will be used during the plugging of the well it must be permitted. A CDP-1 form must be filed and approved prior to the use of the pit in accordance with K.A.R. 82-3-600.**

The Conservation Division's review of form CP-1, either in the central or district office, does not include an inquiry into well ownership or the filing operator's legal right to plug the well. This notice in no way constitutes authorization to plug the above well by persons not having legal rights of ownership or interest in the well.

This notice is void after February 25, 2008. The CP-1 filing does not bring the above well into compliance with K.A.R. 82-3-111 with regard to the Commission's temporary abandonment requirements.

Sincerely,

Steve Bond
Production Department Supervisor

District: #1
210 E Frontview, Suite A
Dodge City, KS 67801
(620) 225-8888