


STATE OF KANSAS  
STATE CORPORATION COMMISSION

WELL PLUGGING RECORD

Give All Information Completely  
Make Required Affidavit  
Mail or Deliver Report to:  
Conservation Division  
State Corporation Commission  
800 Biting Building  
Wichita, Kansas

OR  
FORMATION PLUGGING RECORD Strike out upper line when reporting plugging of formations.

Rooks County. Sec. Twp. 27 Rge. 9 (E) 19 (W)  
Location as "NE 1/4 NW 1/4 SW 1/4" or footage from lines 660'S 330'W of N/4 Corner  
Lease Owner Cities Service Oil Co.  
Lease Name Mongeau Well No. 2  
Office Address Bartlesville, Oklahoma  
Character of Well (completed as Oil, Gas or Dry Hole) Dry Hole  
Date well completed 1-27 1949  
Application for plugging filed 1-27 1949  
Application for plugging approved 1-27 1949  
Plugging commenced 1-27 1949  
Plugging completed 1-28 1949  
Reason for abandonment of well or producing formation Dry Hole

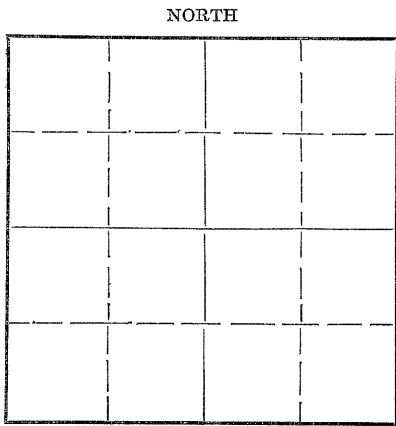

Locate well correctly on above Section Plat

If a producing well is abandoned, date of last production 19  
Was permission obtained from the Conservation Division or its agents before plugging was commenced? Yes

Name of Conservation Agent who supervised plugging of this well M. A. Rives Hays, Kansas  
Producing formation Arbuckle Lime Depth to top 3673 Bottom Total Depth of Well 3709 Feet  
Show depth and thickness of all water, oil and gas formations.

OIL, GAS OR WATER RECORDS

CASING RECORD

Formation	Content	From	To	Size	Put In	Pulled Out
Arbuckle Lime	Dry			8 5/8	298	None

Describe in detail the manner in which the well was plugged, indicating where the mud fluid was placed and the method or methods used in introducing it into the hole. If cement or other plugs were used, state the character of same and depth placed, from feet to feet for each plug set.

Filled with heavy mud from total depth 3709 to 250 feet, set bridgeplug 15 sacks cement through drill pipe, heavy mud to 30 feet, dumped 10 sacks cement mud and dirt to surface.

RECORDED  
2/16/49  
FEB 1  
STATE OF KANSAS  
CORPORATION COMMISSION

(If additional description is necessary, use BACK of this sheet)

Correspondence regarding this well should be addressed to Mr. R. C. Cooper  
Address P.O. Box 751 Great Bend, Kansas

STATE OF Kansas, COUNTY OF Barton, ss.  
Mr. James Porter (employee of owner) or ~~owner~~ of the above-described well,

being first duly sworn on oath, says: That I have knowledge of the facts, statements, and matters herein contained and the log of the above-described well as filed and that the same are true and correct. So help me God.

(Signature) James Porter

D.O. Box 553, Russell, Kansas (Address)

SUBSCRIBED AND SWORN to before me this 2nd day of February, 1949

My commission expires 3-17-1951

W. G. Smith  
Notary Public.

PLUGGING  
FILE SEC 27 T 9 R 19 W  
BOOK PAGE 81 LINE 16

# WELL RECORD

15-163-02907-00-66

Company Circle Service Oil Co. Well No. 2 Farm 5040000  
 Location 660' South and 330' West of N/A Corner Sec. 27 T. 9 R. 19W  
 Elevation 2204 (2201 dr.) County Rooks State Kansas  
 Drig. Comm. January 16, 1949 Contractor Prime Drilling Company  
 Drig. Comp. January 27, 1949 Acid None  
 T. D. 3709' Initial Prod. Dry hole - plugged and abandoned 1-27-49

7-7/8" 296' con. w/ 170 sq con. & 100' C. C.

FORMATION LOG:  
 surface clay & sand 0-70  
 shale & shells 296  
 shale 500  
 shale & shells 885  
 sand 965  
 shale & shells 1055  
 sand 1290  
 shale, shells & red bed 1565  
 anhydrite 1605  
 shale & shells 2035  
 lime & shale 2100  
 shale & lime 2170  
 lime & shale 2650  
 shale & lime 3190  
 lime 3670  
 lime & chert 3709 T. D.

Lossing 3400'  
 Cherty Conglomerate 3655'  
 Arbuckle 3673'  
 Penetration 36'  
 Total Depth 3709'

GAZE TRACTS (TOTAL): 500' 0"  
 1000' 10"  
 1500' 10"  
 2000' 10"  
 2500' 0"  
 3000' 0"

7-7/8" rotary hole.

## PLUGGING

FILE SEC 27 T. 9 R. 19W  
 BOOK PAGE 81 LINE 16

