

15-163-02971-00-00

STATE OF KANSAS
STATE CORPORATION COMMISSION

WELL PLUGGING RECORD


Give All Information Completely
Make Required Affidavit
Mail or Deliver Report to:
Conservation Division
State Corporation Commission
800 Biting Building
Wichita, Kansas

OR

FORMATION PLUGGING RECORD

Strike out upper line
when reporting plug-
ging off formations.

NORTH

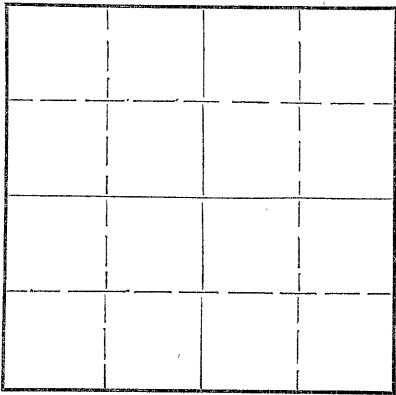

Locate well correctly on above
Section Plat

Rooks County. Sec. 27 Twp. 9 Rge. (E) 19 (W)
Location as "NE 1/4 NW 1/4 SW 1/4" or footage from lines 990'S 660'E of Center
Lease Owner Cities Service Oil Co.
Lease Name Sikes Well No. 3
Office Address Bartlesville, Oklahoma
Character of Well (completed as Oil, Gas or Dry Hole) Dry Hole
Date well completed 1-10 1949
Application for plugging filed 1-10 1949
Application for plugging approved 1-10 1949
Plugging commenced 1-10 1949
Plugging completed 1-11 1949
Reason for abandonment of well or producing formation Dry Hole

If a producing well is abandoned, date of last production 19
Was permission obtained from the Conservation Division or its agents before plugging was com-
menced? yes

Name of Conservation Agent who supervised plugging of this well M. A. Rives Hays, Kansas
Producing formation Arbuckle Lime Depth to top 3686' Bottom Total Depth of Well 3701' Feet
Show depth and thickness of all water, oil and gas formations.

OIL, GAS OR WATER RECORDS

CASING RECORD

Formation	Content	From	To	Size	Put In	Pulled Out
Arbuckle Lime	Water			8 5/8	305	None

Describe in detail the manner in which the well was plugged, indicating where the mud fluid was placed and the method or methods used in introducing it into the hole. If cement or other plugs were used, state the character of same and depth placed, from feet to feet for each plug set.

Filled with heavy mud from TD 3701 to 250' Set wood plug dumped 15 sack
Cement heavy mud to 30 feet set wood plug dumped 10 sacks cement mud and dirt
to surface.

2/16/49
FED

(If additional description is necessary, use BACK of this sheet)

Correspondence regarding this well should be addressed to Mr. R. C. Cooper
Address Box 751, Great Bend, Kansas

STATE OF Kansas, COUNTY OF Barton, ss.

Mr. James Porter (employee of owner) or (owner/operator) of the above-described well,
being first duly sworn on oath, says: That I have knowledge of the facts, statements and matters herein contained and the log of the above-
described well as filed and that the same are true and correct. So help me God.

(Signature)

Box 553, Russell, Kansas (Address)


SUBSCRIBED AND SWORN TO before me this 25th day of January, 1949

My commission expires 3-17-1951

Notary Public.

22-2625

2-48-15M

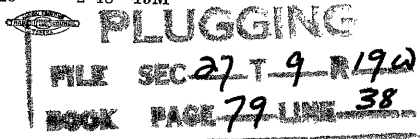

WELL RECORD

15-163-02971-00-00

 Location 990' South & 660' East of Center Sec. 27 T. 9 R. 19W
 Drlg. Comm. December 31, 1948 Contractor Prins Drilling Company
 Drlg. Comp. January 11, 1949 Acid None
 T. D. 3701' Initial Prod. None - Dry Hole - PMA 1-11-49

3-3/8" 305' cas. 175 psi cement

FORMATION LOGGED:

surface clay	0-40
sand	60
shale & shells	306
shale	300
shale & shells	735
sand	765
shale & shells	1030
sand	1280
shale, shells & red bed	1569
anhydrite	1610
shale & shells	2050
lime & shale	2170
lime	2230
lime & shale	2645
shale & shells	2905
shale & lime	3145
lime	3565
lime & shale	3626
cored shale & shaly dol.	3630
cored shaly dol. & shale	3635
lime & shale	3660
chert & lime	3685
lime	3701 T. D.

Top Lensing	3390'
Top Area. Artuckle	3616'
Top Artuckle	3686'
Penetration	15'
Total Depth	3701'

SLOPE TESTS (TORCO):

500'	0°
1000'	0°
1500'	1/2°
2000'	1/2°
2500'	1/2°
3000'	3/4°

7-7/8" rotary hole.

PLUGGING

FILE SEC 27 T 9 R 19W

BOOK PAGE 79 LINE 38

RECEIVED
 FEB 11 1949
 OIL & GAS DIVISION
 STATE OF KANSAS

CITIES



SERVICE

FIELD PURCHASE ORDER

№ 270282

L.S.O.

CO.

Field Warehouse Order Number

Date *1-26-49*

Issued to

State Corporation Commission

City

Topeka

State

Kans

Material to be used for

ACCOUNT NO.

THIS COPY TO BE RETAINED BY VENDOR
VENDOR TO SHOW THIS FIELD ORDER NUMBER ON INVOICE WHICH IS TO BE DELIVERED TO
EMPLOYEE WITH MATERIAL. OTHERWISE VENDOR TO SEND INVOICE TO BARTLESVILLE, OKLAHOMA
OFFICE, PURCHASING DEPARTMENT.

QUANTITY	SIZE	DESCRIPTION	PRICE
<i>Inv</i>	<i>NO #</i>	<i>Likes #3</i>	<i>B41581</i>
<i>✓</i>	<i>NO #</i>	<i>Wessinger B-1</i>	<i>B41576</i>

PLUGGING
 FILE SEC *27* T *9* R *196* N
 BOOK PAGE *79* LINE *38*

PLUGGING
 FILE SEC *01* T *11* R *186*
 BOOK PAGE *79* LINE *13*

Signed *R. J. Turner*

USE CITIES SERVICE PRODUCTS