

WELL PLUGGING RECORD

Give All Information Completely
Make Required Affidavit
Mail or Deliver Report to:
Conservation Division
State Corporation Commission
212 No. Market
Wichita, Kansas

Rooks County, Sec. 27 Twp. 9S Rge. 17 (E) W (W)

Location as "NE/CNW/SW" or footage from lines 990' FEL & 990' FNL

Lease Owner Cities Service Oil Company

Lease Name Bartos Well No. A #5

Office Address Box 553 Russell, Kansas

Character of Well (completed as Oil, Gas or Dry Hole) Dry Hole

Date well completed 3-28 19 67

Application for plugging filed 3-29 19 67

Application for plugging approved 3-30 19 67


Plugging commenced 3-28 19 67

Plugging completed 3-28 19 67

Reason for abandonment of well or producing formation

If a producing well is abandoned, date of last production 19

Was permission obtained from the Conservation Division or its agents before plugging was commenced?

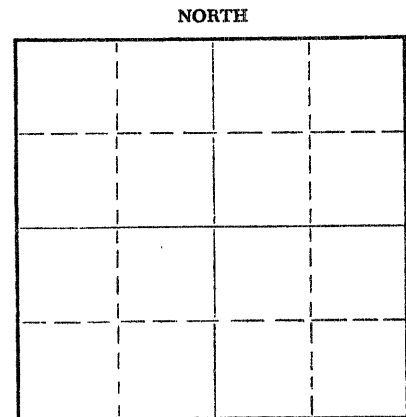

Locate well correctly on above Section Plat

Name of Conservation Agent who supervised plugging of this well Mr. Leo Massey Box 582 Hays, Kansas

Producing formation Depth to top Bottom Total Depth of Well 3785 Feet

Show depth and thickness of all water, oil and gas formations.

OIL, GAS OR WATER RECORDS

CASING RECORD

FORMATION	CONTENT	FROM	TO	SIZE	PUT IN	PULLED OUT
				8 5/8"	337'	

Describe in detail the manner in which the well was plugged, indicating where the mud fluid was placed and the method or methods used in introducing it into the hole. If cement or other plugs were used, state the character of same and depth placed, from feet to feet for each plug set.

Filled hole W/heavy rotary mud to 550'
Set Howco plug at 550'
Spotted thru drill pipe 25 sacks on plug at 550'
Filled with heavy mud to 320'
Set Howco plug at 320'
Spotted 20 sacks cement on plug at 320' thru drill pipe
Filled hole W/heavy rotary mud to 40'
Set Howco plug at 40' Pshed 1 sack hulls down on plug and one sack dry cement down on plug at 40'
Filled hole with cement to bottom of cellar.

RECEIVED
STATE CORPORATION COMMISSION
5/15/67
MAY 15 1967
CONSERVATION DIVISION
Wichita, Kansas

(If additional description is necessary, use BACK of this sheet)

Name of Plugging Contractor Garvey Drilling Inc.

Address 300 West Douglas Wichita, Kansas

STATE OF Kansas, COUNTY OF Russell, ss.

M. M. Hardin (employee of owner) or (owner or operator) of the above-described well, being first duly sworn on oath, says: That I have knowledge of the facts, statements, and matters herein contained and the log of the above-described well as filed and that the same are true and correct. So help me God.

(Signature) M.M. Hardin M.M. Hardin, Dist. Supt.

Box 553 Russell, Kansas 67665

(Address)

SUBSCRIBED AND SWORN TO before me this 11th day of May, 19 67

My commission expires 10-5-68

James F. Kyger Notary Public.

WELL RECORD

Company Cities Service Oil Company Well No. A 95 Farm Barton
 Initial Prod. Dry and Abandoned 3-28-67 Contractor Garvey Drilling Company
 Acid _____ Drlg. Comm. 3-28-67
 T. D. 3785' Drlg. Comp. 3-28-67

Casing Record:

6 5/8" At 330' w/250 Sacks

Formation Records

Formation Records	Depth
Top soil and Sand	30'
Shale	755'
Sand with shale	950'
Shale	1265'
Sand and Pyrite	1330'
Shale and Sand	1540'
Anhydrite	1570'
Shales, Shells and Red bed	2075'
Lime and Shale Strata	2150'
Lime	2215'
Lime and Shale	3300'
Lime	3316'
Lime and Shale	3400'
Lime	3600'
Lime and Chert	3785'

Electric Log Tags:

Topsoil	3162' (- 954)
Heabrow	3372' (-1164)
Terrace	3392' (-1184)
Leaving	3412' (-1204)
Base Kansas City	3632' (-1424)
Conglomerate	3654' (-1446)
Arbuckle	3732' (-1524)

Slone Tests Electron

200'	1/2
550'	1 1/4
1250'	1 1/2
2350'	1/2
3250'	1

RECEIVED
 STATE CONSERVATION COMMISSION

MAY 12 1967

CONSERVATION DIVISION
 Wichita, Kansas