


WELL PLUGGING RECORD

Give All Information Completely
Make Required Affidavit
Mail or Deliver Report to:
Conservation Division
State Corporation Commission
800 Bitting Building
Wichita, Kansas

NORTH

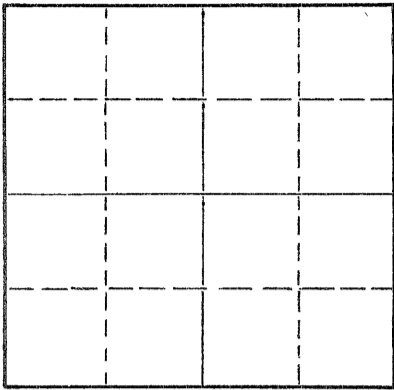

Locate well correctly on above
Section Plat

Rooks _____ County. Sec. 23 Twp. 9 Rge. 19W (E) _____ (W)
Location as "NE/CNW/SW" or footage from lines C N/2 NE NW
Lease Owner Herman George Kaiser
Lease Name Cerrow Well No. 2
Office Address 908 Palace Bldg., Tulsa, Oklahoma
Character of Well (completed as Oil, Gas or Dry Hole) dry hole
Date well completed October 3, 19 54
Application for plugging filed October 3, 19 54
Application for plugging approved October 3, 19 54
Plugging commenced October 3, 19 54
Plugging completed October 3, 19 54
Reason for abandonment of well or producing formation commercial quantities of
oil not found

If a producing well is abandoned, date of last production _____ 19 ____
Was permission obtained from the Conservation Division or its agents before plugging was commenced? yes

Name of Conservation Agent who supervised plugging of this well Eldon Petty, Box 326, Hays, Kansas
Producing formation _____ Depth to top _____ Bottom _____ Total Depth of Well 3535 Feet
Show depth and thickness of all water, oil and gas formations.

OIL, GAS OR WATER RECORDS

CASING RECORD

FORMATION	CONTENT	FROM	TO	SIZE	PUT IN	PULLED OUT
				8 5/8"	201'	

Describe in detail the manner in which the well was plugged, indicating where the mud fluid was placed and the method or methods used in introducing it into the hole. If cement or other plugs were used, state the character of same and depth placed, from _____ feet to _____ feet for each plug set.

Filled hole with heavy mud from 3535' to 190'. Set wooden plug with 15 sacks cement. Second plug at 40' and capped with 10 sacks cement.

10/8/54

(If additional description is necessary, use BACK of this sheet)

Name of Plugging Contractor K & E DRILLING, INC.
Address 1006 Central Bldg., Wichita, Kansas

STATE OF Kansas, COUNTY OF Sedgwick, ss.
Dale Silcott agent for (employee of owner) or (owner or operator) of the above-described well, being first duly sworn on oath, says: That I have knowledge of the facts, statements, and matters herein contained and the log of the above-described well as filed and that the same are true and correct. So help me God.

(Signature) [Signature]

SUBSCRIBED AND SWORN TO before me this 6th day of October, 19 54

(Address) [Signature]
Frances Mader
Notary Public.

My commission expires June 25, 1956

