

15-163-02966-00-00

STATE OF KANSAS
STATE CORPORATION COMMISSION

Give All Information Completely
Make Required Affidavit
Mail or Deliver Report to:
Conservation Division
State Corporation Commission
800 Bittling Building
Wichita, Kansas

WELL PLUGGING RECORD

Rooks County. Sec. 23 Twp. 9 Rge. 19 (E) W (W)

Location as "NE/CNW/SW" or footage from lines SE SE NW

Lease Owner C-G Drilling Company

Lease Name Cerrow Well No. 1

Office Address Wichita, Kansas

Character of Well (completed as Oil, Gas or Dry Hole) Dry Hole

Date well completed 10-20-52 19

Application for plugging filed 10-30-52 19

Application for plugging approved 10-30-52 19


Plugging commenced 10-30-52 19

Plugging completed 11-3-52 19

Reason for abandonment of well or producing formation too low structurally

If a producing well is abandoned, date of last production _____ 19

Was permission obtained from the Conservation Division or its agents before plugging was commenced? Yes

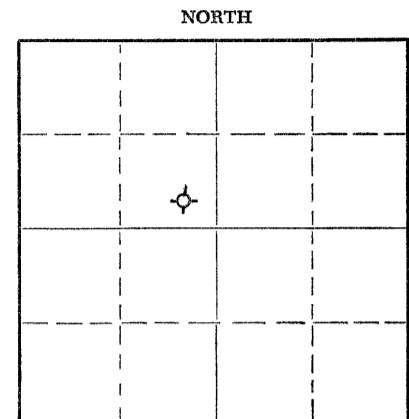

Locate well correctly on above Section Flat

Name of Conservation Agent who supervised plugging of this well Eldon Petty

Producing formation _____ Depth to top _____ Bottom _____ Total Depth of Well _____ Feet

Show depth and thickness of all water, oil and gas formations.

OIL, GAS OR WATER RECORDS

CASING RECORD

FORMATION	CONTENT	FROM	TO	SIZE	PUT IN	PULLED OUT
				5-1/2"	3559.29'	2780'
				8-5/8"	153.80'	

Describe in detail the manner in which the well was plugged, indicating where the mud fluid was placed and the method or methods used in introducing it into the hole. If cement or other plugs were used, state the character of same and depth placed, from _____ feet to _____ feet for each plug set.

Sanded hole from 3518' to 3500' and ran 4 sacks of cement. Mudded hole to 1616, set 10' rock bridge and ran 15 sacks of cement. Mudded hole to 35' and ran 10 sacks of cement. Plugging completed.

RECEIVED
STATE CORPORATION COMMISSION
NOV 12 1952
CONSERVATION DIVISION
Wichita, Kansas

(If additional description is necessary, use BACK of this sheet)

Name of Plugging Contractor West Supply Company

Address Chase, Kansas

STATE OF KANSAS, COUNTY OF SEDGWICK, ss.

Vicky Jacobs (employee of owner) or ~~(owner or operator)~~ of the above-described

well, being first duly sworn on oath, says: That I have knowledge of the facts, statements, and matters herein contained and the log of the above-described well as filed and that the same are true and correct. So help me God.

(Signature) Vicky Jacobs

Union Nat'l Bank Bldg., Wichita, Kansas

(Address)

SUBSCRIBED AND SWORN to before me this 7th day of November, 19 52

My commission expires 11-21-55

Marilyn Schmidt Notary Public.

PLUGGING
FILE SEC 23 T 9 R 1934
BOOK PAGE 57 LINE 15

CONTRACTOR'S WELL LOG

OPERATOR C-G DRILLING CO. FARM NAME CERROW #1
 LOCATION SE SE NW Sec. 23-9-19W
 POOL NAME Wildcat COUNTY Rooks STATE Kansas
 COMMENCEMENT DATE October 6, 1952 COMPLETION DATE October 20, 1952

LOG OF WELL

Elevation: 2094 R. B.
 All measurements from the top of rotary bushing.

FROM	TO	FORMATION	DEVIATION FROM VERTICAL	REMARKS:
0	151			
151	380	Shale-Sand		
380	575	Shale		
575	635	Sand		
635	825	Sand		
825	1190	Sand		
1190	1340	Sand-Shale		
1340	1474	Red Bed		
1474	1511	Anhydrite	0° - 1500'	
1511	1725	Shale		
1725	1930	Shale-Lime		
1930	2070	Shale-Lime	0° - 2000'	
2070	2210	Lime-Shale		
2210-	2350	Lime-Shale		
2350	2450	Lime-Shale		
2450	2548	Lime-Shale	0° - 2500'	
2548	2645	Lime-Shale		
2645	2720	Lime-Shale		
2720	2785	Lime-Shale		
2785	2900	Lime-Shale		
2900	3015	Lime-Shale	0° - 3000'	
3015	3090	Lime-Shale		
3090	3135	Lime-Shale		
3135	3195	Lime-Shale		
3195	3255	Lime-Shale		
3255	3295	Lime		
3295	3340	Lime		
3340	3385	Lime		
3385	3430	Lime		
3430	3470	Lime		
3470	3511	Lime-Shale	0° - 3500'	
3511	3518	Lime-Shale		

CASING LEFT IN HOLE AFTER COMPLETION

Ran 153.80' (5 jts.) 8 5/8" OD Casing.
 Set 779.29' of 5 1/2" OD Casing.

STATE OF KANSAS, COUNTY OF SEDGWICK) ss.

The undersigned certifies that to the best of her knowledge and belief, the above facts are true and correct.

C-G DRILLING CO.

By Vicky Jacobs

Subscribed and sworn to before me this 7th day of November, 1952.

My commission expires: 11-21-55

Marilyn Schmidt

Notary Public

RECEIVED
 STATE CORPORATION COMMISSION

NOV 12 1952

CONSERVATION DIVISION
 Wichita, Kansas

PLUGGING
 FILE SEC 23-9-19W
 BOOK PAGE 57 LINE 15