


STATE OF KANSAS
- STATE CORPORATION COMMISSION

Give All Information Completely
Make Required Affidavit
Mail or Deliver Report to:
Conservation Division
State Corporation Commission
212 No. Market
Wichita, Kansas

WELL PLUGGING RECORD

NORTH

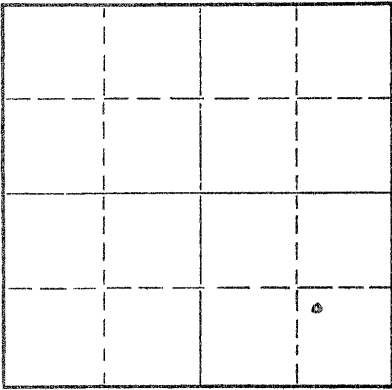

Locate well correctly on above
Section Plat

Rooks County. Sec. 23 Twp. 9 Rge. (E) 19(W)
Location as "NE/CNW/SW" or footage from lines NW SE SE
Lease Owner Four-Way Operating, Inc.
Lease Name Saindon Well No. 5 A
Office Address Box 698, Great Bend, Kansas
Character of Well (completed as Oil, Gas or Dry Hole) oil
Date well completed _____ 19____
Application for plugging filed April 24 19 67
Application for plugging approved _____ 19____
Plugging commenced June 12 19 67
Plugging completed June 14 19 67
Reason for abandonment of well or producing formation depleted

If a producing well is abandoned, date of last production _____ 19____
Was permission obtained from the Conservation Division or its agents before plugging was commenced? yes

Name of Conservation Agent who supervised plugging of this well Leo F. Massey
Producing formation _____ Depth to top _____ Bottom _____ Total Depth of Well 3557 Feet
Show depth and thickness of all water, oil and gas formations.


OIL, GAS OR WATER RECORDS

CASING RECORD

FORMATION	CONTENT	FROM	TO	SIZE	PUT IN	PULLED OUT
		0	320'	8 5/8"	320'	none
		0	3552'	5 1/2"	3552'	none

Describe in detail the manner in which the well was plugged, indicating where the mud fluid was placed and the method or methods used in introducing it into the hole. If cement or other plugs were used, state the character of same and depth placed, from _____ feet to _____ feet for each plug set.

Pushed plug to 3350', set 10' rock bridge and dumped 5 sacks of cement at 3340'.
Pushed plug to 315', set 10' rock bridge and filled hole with 3 1/2 yards of ready mix concrete.

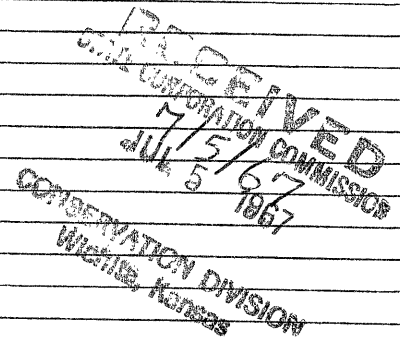

(If additional description is necessary, use BACK of this sheet)
Name of Plugging Contractor Pipe Pullers, Inc.
Address Box 486, Ellinwood, Kansas

STATE OF Kansas, COUNTY OF Barton, ss.
Dean Wells

(employee of owner) or (owner or operator) of the above-described well, being first duly sworn on oath, says: That I have knowledge of the facts, statements, and matters herein contained and the log of the above-described well as filed and that the same are true and correct. So help me God.

(Signature) Dean Wells
Ellinwood, Kansas
(Address)

SUBSCRIBED AND SWORN TO before me this 22nd day of June, 1967

My commission expires July 7, 1968

J. J. Rader
Notary Public.

15-163-03538-00-00

WELL RECORD

Company Cities Service Oil Co. Well No. 5-A Farm Saindon
 Location 1024' North end 956' West of SE Corner Sec. 23 T. 9 R. 19W
 Elevation 2135 (2132 Gr.) County Rooks State Kansas
 Drlg. Comm. June 22, 1951 Contractor R. W. Rine Drilling Company
 Drlg. Comp. July 13, 1951 Acid 500 gals. July 14, 1951
 T. D. 3557' Initial Prod. Physical Potential: 49 oil, 147 water, 24 hrs. (9-18-51)

CASING RECORD:

3-5/8" @ 320' con. 175 sx cement
 5-1/2" @ 3552' con. 150 sx cement

Set D-V tool at 1544', 425 sx cement through perforations.

FORMATION RECORD:

clay, sand & shale	250
shale & clay	320
shale, sand & shells	1000
sand, shale & shells	1510
lime & anhydrite	1545
shale & shells	2055
shale	2325
lime	2465
lime & shale	2585
shale & lime	2765
lime, shale & shells	2885
lime & shale	3145
shale & lime	3210
lime	3553

3553 RTD = 3553 SLK

lime

3557 T. D.

12/2/57

7-7/8" rotary hole.
 Plugback; 11/29/57 w/ Lane
 walls plug at 3516'

Perf 43sh. 3436-48; No fluid

" 57sh. 3345-09; " "

" 33sh 3384-92; 22 gals
 muddy wtr
 in 40 min

133sh

LW Plug @ 337?

Lansing	3303'
Eros. Arbuckle	3548'
Arbuckle	3551'
Penetration	6'
Total Depth	3557'

1 1/2 bailers water with good show
 oil in 40 mins.

RECEIVED
 STATE CORPORATION COMMISSION

SYFO: 500' 00
 1000' 00
 1500' 00
 2000' 10
 2500' 20
 3000' 10
 APR 25 1967
 OBSERVATION DIVISION
 Wichita, Kansas