


STATE OF KANSAS
STATE CORPORATION COMMISSION

WELL PLUGGING RECORD

Give All Information Completely
Make Required Affidavit
Mail or Deliver Report to
Conservation Division
State Corporation Comm.
245 North Water
Wichita, KS 67202

Rooks _____ County. Sec. 20 Twp. 9 Rge. 19 XE/W
Location as "NE/CNW $\frac{1}{4}$ SW $\frac{1}{4}$ " or footage from lines _____
SW SW SE
Lease Owner Landes Exploration Co.
Lease Name Landes & Hellar-Wanker Well No. 1
Office Address Rox 867, Magnolia, Arkansas 71753
Character of Well (Completed as Oil, Gas or Dry Hole) _____

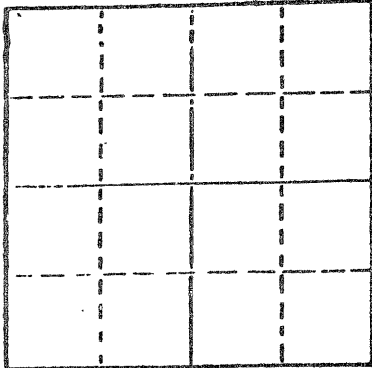

Locate well correctly on above
Section Plat

Dry Hole
Date Well completed 9-24 1977
Application for plugging filed 9-24 1977
Application for plugging approved 9-24 1977
Plugging commenced 9-24 1977
Plugging completed 9-24 1977
Reason for abandonment of well or producing formation _____

Dry Hole
If a producing well is abandoned, date of last production _____ 19____

Was permission obtained from the Conservation Division or its agents before plugging was commenced? yes

Name of Conservation Agent who supervised plugging of this well Leo Massey
Producing formation _____ Depth to top _____ Bottom _____ Total Depth of Well 3690'
Show depth and thickness of all water, oil and gas formations.

OIL, GAS OR WATER RECORDS

CASING RECORD

FORMATION	CONTENT	FROM	TO	SIZE	PUT IN	PULLED OUT
Surface Pipe		0'	210'	8 5/8"	210'	0'

Describe in detail the manner in which the well was plugged, indicating where the mud fluid was placed and the method or methods used in introducing it into the hold. If cement or other plugs were used, state the character of same and depth placed, from _____ feet to _____ feet for each plug set.

1st plug was set @ 775' w/ 70 sacks cement
2nd plug was set @ 200' w/20 sacks cement
3rd plug was set @ 40' w/10 sacks cement

RECEIVED
STATE CORPORATION COMMISSION
9/28/77
SEP 28 1977

CONSERVATION DIVISION
Wichita, Kansas

(If additional description is necessary, use BACK of this sheet)

Name of Plugging Contractor Dreiling Oil, Inc.

STATE OF KANSAS COUNTY OF ELLIS, ss.

I, Joseph A. Hess, Sec. Treas. of Drlg. Contrc. (employee of owner) or (owner or operator) of the above-described well, being first duly sworn on oath, says: That I have knowledge of the facts, statements, and matters herein contained and the log of the above-described well as filed and that the same are true and correct. So help me God.

(Signature) Joseph A. Hess
JOSEPH A. HESS, HAYS, KS 67601
(Address)

SUBSCRIBED AND SWORN TO before me this 27th day of September, 19 77

Cecilia Basgall
Cecilia Basgall Notary Public.

My commission expires November 17, 1980.

CECILIA BASGALL
NOTARY PUBLIC
Ellis County, Kansas

DREILING OIL, INC.

Victoria, Kansas 67671

15-163-20735-00-00

Landes Exploration Co. **WELL LOG**
 Box 867
 Magnolia, Arkansas 71753
 Landes & Hellar

Company
Farm Wanker No. 1
Total Depth 3,690'
Comm. 9-15-77 **Comp.** 9-24-77
Contractor Dreiling Oil, Inc.
 Rt. #1
 Victoria, KS 67671

Sec. 20 **Twp.** 9 **Rng.** 19
Location SW SW SE
County Rooks
Elevation: 2175 **K. B.**
 2172 **D. F.**
 2170 **G. R.**

Casing Record **Cement Record** **Production:**
 210' - 8 5/8" 135 sacks cement D & A


Figures Indicate Bottom of Formations

0'	170'	Shale
170'	1569'	Shale
1569'	1608'	Anhydrite
1608'	2075'	Shale
2075'	2820'	Lime & Shale
2820'	3020'	Shale
3020'	3520'	Lime & Shale
3520'	3555'	Lime
3555'	3615'	Lime & Shale
3615'	3644'	Arbuckle
3644'	3690'	Arbuckle
3690'	T. D.	

RECEIVED
 STATE CORPORATION COMMISSION
 SEP 28 1977
 CONSERVATION DIVISION
 Wichita, Kansas

STATE OF KANSAS)
)ss
 COUNTY OF ELLIS)

I, Joseph A. Hess, Secretary Treasurer of Dreiling Oil, Inc., upon oath states that the above and foregoing is a true and correct copy from the Daily Drilling Report from the Wanker #1.


 JOSEPH A. HESS

Subscribed and sworn to before me this 27th day of September, 1977.

CECILIA BASGALL
 NOTARY PUBLIC
 Ellis County, Kansas


 Cecilia Basgall Notary Public

My appointment expires: November 17, 1980.