


15-163-00574-00-00

STATE OF KANSAS
STATE CORPORATION COMMISSION

Give All Information Completely
Make Required Affidavit
Mail or Deliver Report to:
Conservation Division
State Corporation Commission
800 Biting Building
Wichita, Kansas

WELL PLUGGING RECORD

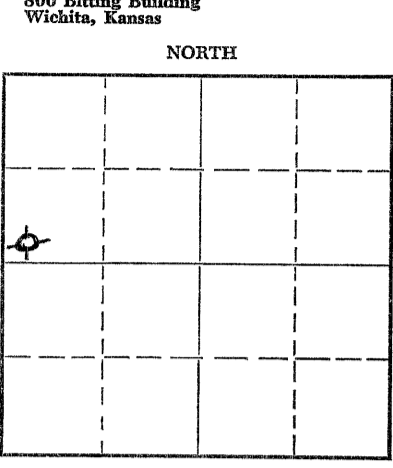

Locate well correctly on above
Section Plat

Rooks _____ County. Sec. 19 Twp. 9S Rge. (E) 19 (W)
Location as "NE/CNW/SW" or footage from lines SW SW NW
Lease Owner K & E Drilling, Inc.
Lease Name Barber Well No. 1
Office Address 1006 Central Bldg., Wichita, Kansas
Character of Well (completed as Oil, Gas or Dry Hole) Dry hole
Date well completed January 15 1954
Application for plugging filed January 15 1954
Application for plugging approved January 15 1954
Plugging commenced 4:00 p.m., January 15 1954
Plugging completed 11:30 p.m., January 15 1954
Reason for abandonment of well or producing formation
Commercial quantity of oil not found
If a producing well is abandoned, date of last production _____ 19____
Was permission obtained from the Conservation Division or its agents before plugging was commenced? Yes

Name of Conservation Agent who supervised plugging of this well Eldon Petty
Producing formation _____ Depth to top _____ Bottom _____ Total Depth of Well 3605 Feet
Show depth and thickness of all water, oil and gas formations.

OIL, GAS OR WATER RECORDS

CASING RECORD

FORMATION	CONTENT	FROM	TO	SIZE	PUT IN	PULLED OUT
				8 5/8"	185'	

Describe in detail the manner in which the well was plugged, indicating where the mud fluid was placed and the method or methods used in introducing it into the hole. If cement or other plugs were used, state the character of same and depth placed, from _____ feet to _____ feet for each plug set.

Set two wooden plugs. Filled hole with mud.
Set plug @ 180' with 15 sacks cement
Set plug @ 40' with 10 sacks cement

1/26/54

(If additional description is necessary, use BACK of this sheet)
Name of Plugging Contractor K & E Drilling, Inc.
Address 1006 Central Building, Wichita, Kansas

STATE OF Kansas, COUNTY OF Sedgwick, ss.
Clinton Engstrand (employee of owner) or (owner or operator) of the above-described well, being first duly sworn on oath, says: That I have knowledge of the facts, statements, and matters herein contained and the log of the above-described well as filed and that the same are true and correct. So help me God.

(Signature) [Signature]
1006 Central Building, Wichita, Kans.
(Address)

SUBSCRIBED AND SWORN TO before me this 22 day of January, 19 54

My commission expires 10-29-55
[Signature] Notary Public.

24-7368-S 3-53-20M

PLUGGING
FILE REC 12 J 9 1954
BOOK PAGE 8 LINE 45

15-163-00574-00-00

K & E DRILLING, INC.
NO. 1 BARBER

SW SW NW Sec. 19-9S-19W
Rooks County, Kansas

Casing
~~8-578~~ Set @ 185'

Cement
125 Sacks

Comm: 1-5-54
Comp: 1-15-54
Total Depth: 3605'

<u>FORMATION</u>	<u>DEPTH</u>
Surface soil	0 - 50
Shale, strks. of sand	50 - 185
Shale	185 - 415
Shale, shells & sand strks.	415 - 778
Sand	778 - 830
Shale and sand, lots of iron	830 - 1020
Sand	1020 - 1035
Sand	1035 - 1258
Shale and shells	1258 - 1542
Anhydrite	1542 - 1552
Anhydrite	1552 - 1577
Shale and shells	1577 - 1845
Shale	1845 - 2020
Shale ans shells	2020 - 2120
Shale and shells	2120 - 2155
Lime and shale	2155 - 2315
Lime	2315 - 2420
Lime and shale	2420 - 2640
Shale and lime	2640 - 2818
Lime and shale	2818 - 2920
Shale	2920 - 3011
Lime and shale	3011 - 3025
Shale	3025 - 3110
Lime and shale	3110 - 3126
Lime and shale	3126 - 3199
Lime	3199 - 3254
Lime and shale	3254 - 3338
Lime (dense)	3338 - 3378
Lime and shale	3378 - 3425
Lime	3425 - 3447
Lime	3447 - 3526
Lime and shale	3526 - 3568
Conglomerate	3568 - 3577
Arbuckle lime	3577 - 3605

STATE OF KANSAS)
) SS
SEDGWICK COUNTY)


I hereby certify that the above information is true and correct to the best of my knowledge.

[Handwritten Signature]

Subscribed and sworn to before me this 22 day of January, 1954.

[Handwritten Signature]
Notary Public

My Commission Expires: 10-29-55

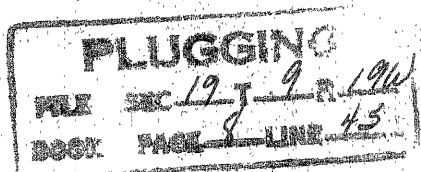

PAN AMERICAN PETROLEUM CORPORATION

CENTRAL DIVISION

FIELD PURCHASE ORDER

CE N° 36032

ORDERED FROM

Kansas State Corporation Comm. DATE *3/19*, 19*58*

ADDRESS

212 No Market, Wichita, Kansas

TERMS

Net FOB *Delivered*

DELIVER TO

RENDER INVOICE IN DUPLICATE FOR EACH ORDER. SHOW ORDER NUMBER ON ALL COPIES OF INVOICE AND MAIL TO PAN AMERICAN PETROLEUM CORPORATION

P.O. # 7, Ellinwood, Kans.
CITY STATE

QUANTITY	DESCRIPTION	FEA	SYM	UNIT PRICE	AMOUNT
	<i>Plugging assessment</i>				

CHARGE TO

E. Honorovich Well # 3 abd

- ORIG. OR CHNG. CONST.
- OPERATIONS OR REPAIRS
- REPLACEMENT

USED FOR

Plugging abandoned Well

BY ACCEPTANCE OF THIS ORDER SELLER OR CONTRACTOR AGREES TO AND SHALL BE BOUND BY THE TERMS AND CONDITIONS PRINTED ON THE BACK HEREOF.

PAN AMERICAN PETROLEUM CORPORATION

BY

[Signature]