


STATE OF KANSAS
STATE CORPORATION COMMISSION

Give All Information Completely
Make Required Affidavit
Mail or Deliver Report to:
Conservation Division
State Corporation Commission
800 Bittling Building
Wichita, Kansas

WELL PLUGGING RECORD

15-163-00597-00-00

NORTH

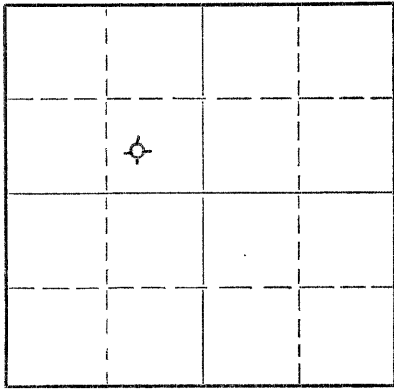

Locate well correctly on above
Section Plat

ROOKS NW County. Sec. 19 Twp. 9S Rge. 19 (E) W (W)
Location as "NE/CNW/SW" or footage from lines SW SE NW
Lease Owner C-G Drilling Company
Lease Name Barber Well No. 1
Office Address Wichita, Kansas
Character of Well (completed as Oil, Gas or Dry Hole) Dry Hole
Date well completed 10-31 1952
Application for plugging filed 11-3 1952
Application for plugging approved 11-3 1952
Plugging commenced 11-3-52 19
Plugging completed 11-7-52 19
Reason for abandonment of well or producing formation too low structurally

If a producing well is abandoned, date of last production 19
Was permission obtained from the Conservation Division or its agents before plugging was commenced? Yes

Name of Conservation Agent who supervised plugging of this well Eldon Petty
Producing formation Depth to top Bottom Total Depth of Well Feet
Show depth and thickness of all water, oil and gas formations.

OIL, GAS OR WATER RECORDS

CASING RECORD

FORMATION	CONTENT	FROM	TO	SIZE	PUT IN	PULLED OUT
				5-1/2"	3580 1/2'	2864'
				8-5/8"	154'	None.

Describe in detail the manner in which the well was plugged, indicating where the mud fluid was placed and the method or methods used in introducing it into the hole. If cement or other plugs were used, state the character of same and depth placed, from feet to feet for each plug set.

Sanded hole from 3594' to 3570' and ran 4 sacks of cement. Mudded hole to 164', set 10' rock bridge and ran 15 sacks of cement. Mudded hole to 35' and ran 10 sacks of cement. Plugging completed.

RECEIVED
STATE CORPORATION COMMISSION
11/20/52
CONSERVATION DIVISION
Wichita, Kansas

(If additional description is necessary, use BACK of this sheet)

Name of Plugging Contractor West Supply Company
Address Chase, Kansas

STATE OF KANSAS, COUNTY OF SEDGWICK, ss.
Vicky Jacobs (employee of owner) or (owner or operator) of the above-described well, being first duly sworn on oath, says: That I have knowledge of the facts, statements, and matters herein contained and the log of the above-described well as filed and that the same are true and correct. So help me God.

(Signature) Vicky Jacobs
Union Nat'l. Bank Bldg., Wichita, Kansas
(Address)

SUBSCRIBED AND SWORN to before me this 14th day of November, 1952

Marilyn Schmidt
Notary Public.

My commission expires November 21, 1955

PLUGGING
FILE SEC 19 T 9 R 1952
BOOK PAGE 58 LINE 27

15-163-00597-00-08

CONTRACTOR'S WELL LOG

OPERATOR C-G DRILLING CO. FARM NAME BARBER #1
LOCATION SW SE NW Sec. 19-9S-19W
POOL NAME Semi-Wildcat COUNTY Rooks STATE Kansas
COMMENCEMENT DATE October 16, 1952 COMPLETION DATE Nov. 7, 1952

LOG OF WELL

Elevation: 2124 R. B.
All measurements from the top of rotary bushing.

FROM	TO	FORMATION	DEVIATION FROM VERTICAL
0	154		
154	320	Sand-Shale	
320	795	Shale-Shells	
795	860	Sand	
860	1030	Shale-Shells	
1030	1280	Sand	
1280	1300	Red Bed	
1300	1585	Sand-Shale-Anhydrite	0° - 1500'
1585	1960	Sand-Shale	
1960	2125	Lime-Shale	0° - 2000'
2125	2300	Lime-Shale	
2300	2420	Lime-Shale	
2420	2550	Lime-Shale	0° - 2500'
2550	2670	Lime-Shale	
2670	2750	Lime-Shale	
2750	2820	Lime-Shale	
2820	2970	Lime-Shale	
2970	3090	Lime-Shale	0° - 3000'
3090	3170	Lime-Shale	
3170	3230	Lime-Shale	
3230	3275	Lime-Shale	
3275	3315	Lime	
3315	3360	Lime	
3360	3395	Lime	
3395	3440	Lime	
3440	3480	Lime	
3480	3520	Lime	0° - 3500'
3520	3565	Lime	
3565	3584	Lime	

CASING LEFT IN HOLE AFTER COMPLETION

Ran 156.65' (5 jts.) 8 5/8" OD Casing.
Set 758.34' (24 jts.) 5 1/2" OD Casing.

STATE OF KANSAS, COUNTY OF SEDGWICK) ss.

The undersigned certifies that to the best of her knowledge and belief, the above facts are true and correct.

C-G DRILLING CO.

By Wicky Jacobs

Subscribed and sworn to before me this 14th day of November, 1952.

My commission expires: 11-21-55

Marilyn Schmidt
Notary Public

RECEIVED
NOV 14 1952
REGISTRY DIVISION
Topeka, Kansas

PLUGGING
FILE SEC 19-9-R-192
BOOK PAGE 58 LINE 27