


STATE OF KANSAS
STATE CORPORATION COMMISSION

WELL PLUGGING RECORD

Give All Information Completely
Make Required Affidavit
Mail or Deliver Report to
Conservation Division
State Corporation Comm.
245 North Water
Wichita, KS 67202

Rooks County, Sec. 19 Twp. 9S Rge. 19 E/W
Location as "NE/CNW 1/4 SW 1/4" or footage from lines

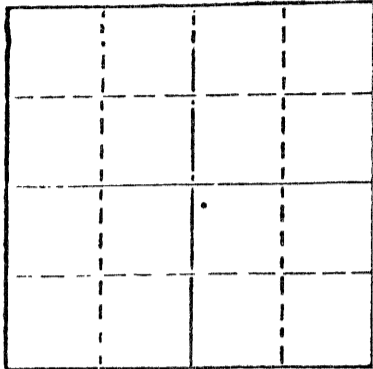

Locate well correctly on above
Section Plat

Lease Owner Liberty Enterprises, Inc.
Lease Name Marcotte Well No. #1
Office Address 308 West Mill Plainville, Ks 67663
Character of Well (Completed as Oil, Gas or Dry Hole)

Dry Hole
Date Well completed November 3 1977
Application for plugging filed November 3 1977
Application for plugging approved November 3 1977
Plugging commenced November 3 12:00 p.m. 1977
Plugging completed November 3 2:00 p.m. 1977

Reason for abandonment of well or producing formation
No commercial production
If a producing well is abandoned, date of last production 19

Was permission obtained from the Conservation Division or
its agents before plugging was commenced? Yes

Name of Conservation Agent who supervised plugging of this well Leo F. Massey
Producing formation Depth to top Bottom Total Depth of Well
Show depth and thickness of all water, oil and gas formations.

OIL, GAS OR WATER RECORDS

CASING RECORD

FORMATION	CONTENT	FROM	TO	SIZE	PUT IN	PULLED OUT
	Surface	0	210'	8 5/8"	210	0

Describe in detail the manner in which the well was plugged, indicating where the mud fluid
was placed and the method or methods used in introducing it into the hold. If cement or other
plugs were used, state the character of same and depth placed, from feet to
feet for each plug set.

Spotted 70 sxs @660'
20 sxs @150'
10 sxs @ 40'
W/1 sack of hulls & plug

(If additional description is necessary, use BACK of this sheet)

Name of Plugging Contractor Helberg Oil Morland, Kansas

STATE OF Kansas COUNTY OF Rooks, ss.
Roger L. Comeau (employee of owner) or (owner or operator)
of the above-described well, being first duly sworn on oath, says: That I have knowledge of
the facts, statements, and matters herein contained and the log of the above-described well
as filed and that the same are true and correct. So help me God.

(Signature) Roger L. Comeau
308 West Mill Plainville, KS 67663
(Address)

SUBSCRIBED AND SWORN TO before me this 14th day of February, 1978

Krystal Schwenn
Notary Public.

My commission expires

