

15-103-00175-00-00

STATE OF KANSAS  
STATE CORPORATION COMMISSION

WELL PLUGGING RECORD


Give All Information Completely  
Make Required Affidavit  
Mail or Deliver Report to:  
Conservation Division  
State Corporation Commission  
800 Bitting Building  
Wichita, Kansas

OR  
FORMATION PLUGGING RECORD

Strike out upper line  
when reporting plug-  
ging off formations.

**Rooks** County. Sec. 24 Twp. 9 Rge. (E) 19 (W)  
Location as "NE $\frac{1}{4}$ NW $\frac{1}{4}$ SW $\frac{1}{4}$ " or footage from lines. SW $\frac{1}{4}$  SW $\frac{1}{4}$  NE $\frac{1}{4}$   
Lease Owner Armer Drilling Company, Inc.  
Lease Name Hilgers Well No. 1  
Office Address 306 Insurance Bldg., Wichita, Kansas  
Character of Well (completed as Oil, Gas or Dry Hole) Dry  
Date well completed. Jan. 17 19 49  
Application for plugging filed. Jan. 17 19 49  
Application for plugging approved. Jan. 17 19 49  
Plugging commenced. Jan. 17 19 49  
Plugging completed. Jan. 17 19 49  
Reason for abandonment of well or producing formation. Dry

NORTH

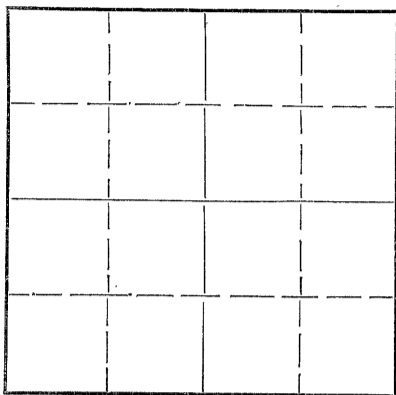

Locate well correctly on above  
Section Plat

If a producing well is abandoned, date of last production. 19\_\_\_\_  
Was permission obtained from the Conservation Division or its agents before plugging was com-  
menced? Yes

Name of Conservation Agent who supervised plugging of this well. C. D. Stough  
Producing formation. Depth to top. Bottom. Total Depth of Well 3640 Feet  
Show depth and thickness of all water, oil and gas formations.

OIL, GAS OR WATER RECORDS

CASING RECORD

Formation	Content	From	To	Size	Put In	Pulled Out
<u>Arbuckle</u>	<u>dry</u>	<u>3621</u>	<u>3640</u>	<u>8-5/8</u>	<u>165'</u>	<u>None</u>

Describe in detail the manner in which the well was plugged, indicating where the mud fluid was placed and the method or methods used in introducing it into the hole. If cement or other plugs were used, state the character of same and depth placed, from \_\_\_\_\_ feet to \_\_\_\_\_ feet for each plug set.

Filled hole with mud to 165', cemented with 15 sacks cement, mud to top, with 10 sacks cement.

11/19/49

(If additional description is necessary, use BACK of this sheet)

Correspondence regarding this well should be addressed to Armer Drilling Company, Inc.  
Address 306 Insurance Bldg., Wichita 2, Kansas

STATE OF KANSAS, COUNTY OF SEDGWICK, ss.

M. B. ARMER

~~Conservation Agent~~

being first duly sworn on oath, says: That I have knowledge of the facts, statements, and matters herein contained and the log of the above-described well as filed and that the same are true and correct. So help me God. ARMER DRILLING COMPANY, INC.

(Signature) By M. B. Armer  
President

SUBSCRIBED AND SWORN TO before me this 19th day of January 19 49.

Hazel Walton  
Notary Public.

My commission expires Sept. 17, 1951

24 9 1949  
80 18

DRILLING LOG

15-163-00175-00-00

To: Armer Drilling Company, Inc.,  
Insurance Building,  
Wichita 2, Kansas.

LEASE: HILGERS #-1:

County: Rooks, Kansas.  
Section: 24-9-19,  
Location: SW/4 SW/4 NE/4

Rotary: Total Depth 3,640'  
Commenced: Jan. 1, 1949; Completed: Jan. 17, 1949:  
Shot or Treated  
Casing: 8-5/8" O.D. 165': 5 1/2" O.D. none  
Production: Dry  
Elev: 2181 D.F.

Contractor: L-S-T Drilling Co., Inc.,  
1316 Union National Bank Building,  
Wichita 2, Kansas.

Figures Indicate Bottom of Formation

	0	To	160	Shale
	160		165	Blue Shale
	165		215	Shale
	215		550	Shell & Shale
	550		850	Shale & Sand
	850		1,250	Sand & Shale
TOPS: (rotary bushing)	1,250		1,410	Shale & Red Bed
Heebner	3332		1,410	Shale, Shell & Red Bed
Toronto	3353		1,460	Shale
Lansing	3373		1,545	Anhydrite
Arbuckle	3621		1,585	Shale & Shell
	1,960		1,960	Shale & Salt
	2,000		2,000	Shale
	2,130		2,130	Lime & Shale
	2,208		2,208	Shale & Lime
	2,320		2,320	Lime
	2,465		2,465	Shale & Broken Lime
	2,520		2,520	Shale & Lime
	2,747		2,747	Lime
	2,860		2,860	Shale & Lime
	2,882		2,882	Broken Lime
	2,963		2,963	Lime Hard
	3,001		3,001	Lime
	3,035		3,035	Shale & Lime
	3,098		3,098	Lime
	3,365		3,365	Ghert & Lime
	3,389		3,389	Lime
	3,588		3,588	Lime & Pyrite
	3,596		3,596	Conglomerate
	3,605		3,605	T.D. Arbuckle Lime

RECORDED  
JAN 19 1949  
STATE DEPARTMENT OF REVENUE  
WICHITA, KANSAS

STATE OF KANSAS |  
                          | SS:  
COUNTY OF SEDGWICK |

I, the undersigned, being duly sworn on oath, state that the above statement and log is true and correct record and log of the well drilled at the location above described.

L-S-T DRILLING COMPANY, INC.,  
By Leah V. Landrus

Subscribed and sworn to before me this 18th day of January 1949

Catherine Darcy  
Notary Public

DRILLING  
FILE SEC 24-9-19  
BOOK PAGE 80 LINE 18

My commission expires March 25, 1952