


Give All Information Completely  
Make Required Affidavit  
Mail or Deliver Report to:  
Conservation Division  
State Corporation Commission  
211 No. Broadway  
Wichita, Kansas

WELL PLUGGING RECORD

15-163-00872-00-00

NORTH

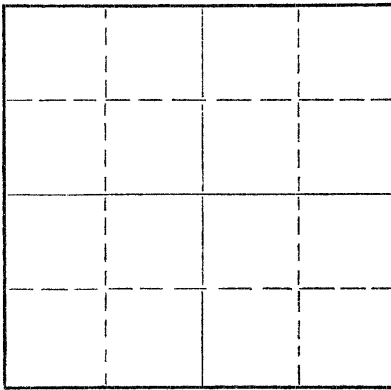

Locate well correctly on above  
Section Plat

Rooks County. Sec. 24 Twp. 9 Rge. 19 (E) (W)

Location as "NE/CNW%SW%" or footage from lines SE SW SE  
Lease Owner Trans Era Petroleum, Inc.  
Lease Name Mayhew Well No. 2  
Office Address 420 W. Douglas, Wichita, Kansas  
Character of Well (completed as Oil, Gas or Dry Hole) Dry Hole  
Date well completed 12/26/55 19  
Application for plugging filed 12/26/55 19  
Application for plugging approved 12/26/55 19  
Plugging commenced 12/26/55 19  
Plugging completed 12/26/55 19  
Reason for abandonment of well or producing formation Dry

If a producing well is abandoned, date of last production \_\_\_\_\_ 19\_\_\_\_  
Was permission obtained from the Conservation Division or its agents before plugging was commenced? yes

Name of Conservation Agent who supervised plugging of this well Eldon Petty  
Producing formation \_\_\_\_\_ Depth to top \_\_\_\_\_ Bottom \_\_\_\_\_ Total Depth of Well 3635 Feet  
Show depth and thickness of all water, oil and gas formations.

OIL, GAS OR WATER RECORDS

CASING RECORD

FORMATION	CONTENT	FROM	TO	SIZE	PUT IN	PULLED OUT
				8 5/8	194	none

Describe in detail the manner in which the well was plugged, indicating where the mud fluid was placed and the method or methods used in introducing it into the hole. If cement or other plugs were used, state the character of same and depth placed, from \_\_\_\_\_ feet to \_\_\_\_\_ feet for each plug set.

PLUGGING RECORD

Filled with heavy rotary mud to 190'. Set Halliburton plug using 1/2 sack hulls and 15 sacks cement through drill pipe to 130'. Filled with heavy rotary mud from 130' to 40' set Halliburton plug, using 1/2 sack hulls and 10 sacks cement to cellar zero

(If additional description is necessary, use BACK of this sheet)

Name of Plugging Contractor Trans Era Petroleum, Inc.  
Address B 420 W. Douglas Ave., Wichita, Kansas

STATE OF KANSAS, COUNTY OF RUSSELL, ss.  
C. T. Honaker (employee of owner) or (owner or operator) of the above-described well, being first duly sworn on oath, says: That I have knowledge of the facts, statements, and matters herein contained and the log of the above-described well as filed and that the same are true and correct. So help me God.

(Signature) C. T. Honaker

(Address)


SUBSCRIBED AND SWORN TO before me this 29 day of December, 19 55

My commission expires 1-30-57

Margie Cooper

Notary Public.

12/30/55

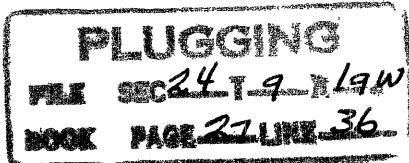

15-163-00872-00-06

Osage Oil & Gas  
Mayhew #2

SE SW SE 24-9-19  
Rooks County, Kansas

Trans Era Petroleum, Inc.

Elev: 2186 DF

Total Depth: 3635

Casing:

Comm: 12/9/55  
Comp: 12/24/55

8 5/8" @ 194 with 150 sacks of Bulk

FORMATION	DEPTH
Surface Clay	40
Shale & sand	100
Sand, shale & shells	194
Shale	500
Shale & sand	610
Shale & shells	735
Sand & shale	1280
Red bed & shale	1532
Anhydrite	1593
Shale & shells	1810
Redbed & salt & shale	2014
Shale & lime	3338
Lime	3635

Tops:		
Heebner		3325
Kansas City		3366 -1178
Arbuckle		3605

STATE OF KANSAS )  
                          ) ss:  
COUNTY OF RUSSELL )

I hereby certify that the above information is true and correct to the best of my knowledge.

C. P. Honaker.

Subscribed and sworn to before me this 29th day of December, 1955.

Margie Cooper  
Notary Public

My commission expires: 1-30-57

PLUGGING  
FILE SEC 24-9-19  
BOOK PAGE 27 LINE 36