

15-163-19332-00-00


STATE OF KANSAS
STATE CORPORATION COMMISSION

WELL PLUGGING RECORD

Give All Information Completely
Make Required Affidavit
Mail or Deliver Report to:
Conservation Division
State Corporation Commission
800 Bittling Building
Wichita, Kansas

Rooks County. Sec. 24 Twp. 9S Rge. 19 (W)

Location as "NE/CNW $\frac{1}{4}$ SW $\frac{1}{4}$ " or footage from lines SW/4 NE/4 SW/4
Lease Owner The Atlantic Refining Co.
Lease Name Stucky Well No. 1
Office Address Box 17, Great Bend, Kansas
Character of Well (completed as Oil, Gas or Dry Hole) Dry hole
Date well completed Nov. 19 1950
Application for plugging filed Nov. 19 1950
Application for plugging approved Nov. 19 1950
Plugging commenced Nov. 20 1950
Plugging completed Nov. 20 1950
Reason for abandonment of well or producing formation dry hole

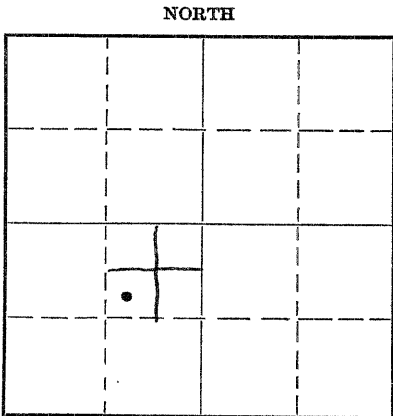

Locate well correctly on above
Section Plat

If a producing well is abandoned, date of last production 19...
Was permission obtained from the Conservation Division or its agents before plugging was commenced? YES

Name of Conservation Agent who supervised plugging of this well Eldon Petty
Producing formation Arbuckle Depth to top 3611 Bottom 3625 Total Depth of Well 3625 Feet
Show depth and thickness of all water, oil and gas formations.


OIL, GAS OR WATER RECORDS

CASING RECORD

Formation	Content	From	To	Size	Put In	Pulled Out
		0	288	8 5/8	273'	0

Describe in detail the manner in which the well was plugged, indicating where the mud fluid was placed and the method or methods used in introducing it into the hole. If cement or other plugs were used, state the character of same and depth placed, from... feet to ... feet for each plug set.

Heavy mud 3625' to 270'
Bridge & 15 sx. 270' to 240'
Heavy mud 240' to 30'
Set Bridge & 10 sx. 30' to Bottom Cellar
cement

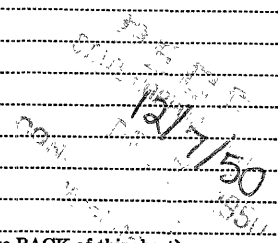

(If additional description is necessary, use BACK of this sheet)
Correspondence regarding this well should be addressed to The Atlantic Refining Co.
Address P.O. Box 17, Great Bend, Kansas

STATE OF Kansas, COUNTY OF Barton, ss.
Stanton K. Myers (employee of owner) or (owner or operator) of the above-described well,

being first duly sworn on oath, says: That I have knowledge of the facts, statements, and matters herein contained and the log of the above-described well as filed and that the same are true and correct. So help me God.

(Signature) Stanton K. Myers

(Address)

SUBSCRIBED AND SWORN to before me this 6th day of December, 1950.

My commission expires October 23, 1954
Notary Public.

PLUGGING
FILE DEC 24 1950
BOOK PAGE 44 LINE 39

THE ATLANTIC REFINING COMPANY
830 KENNEDY BUILDING
TULSA, OKLAHOMA

WELL LOG

SPUDDED: 11-10-50
REACHED T.D.: 11-20-50
PLUGGED: 11-20-50

STUCKY #1 - (Dry Hole)
Center SW NE SW of 24-9S-19W,
Rooks County, Kansas.

Formation Record

<u>Formation</u>	<u>Top</u>	<u>Bottom</u>
Surface hole	0	95
Shale & sand	95	180
Shale shells	180	288
Shale	288	545
Shale shells	545	1335
Red bed	1335	1530
Anhydrite	1530	1565
Shale red bed	1565	1650
Shale shells	1650	2005
Lime & shale	2005	2090
Shale & shells	2090	2265
Shale & lime shells	2265	2400
Shale & lime	2400	3190
Lime & shale	3190	3405
Lime	3405	3625

Total Depth 3625

Top Arbuckle 3611

RECEIVED
STATE CORPORATION
DEC 7 - 1950
CONSERVATION DIVISION
Wichita, Kansas

PLUGGING
FILE DEC 24 9 1950
DATE 11-20-50