

STATE OF KANSAS  
STATE CORPORATION COMMISSION


WELL PLUGGING RECORD

All information Completely  
Required Affidavit  
or Deliver Report to:  
Conservation Division  
State Corporation Commission  
211 No. Broadway  
Wichita, Kansas

Rooks County, Sec. 24 Twp. 9S Rge. 19W (X) (W)

Location as "NE/CNW/SW" or footage from lines Approx. NW SE NE  
Lease Owner D & D Drilling Company, Inc. & Raymond Oil Company  
Lease Name Hilgers "B" Well No. 1  
Office Address 307 Schweiter Building, Wichita, Kansas  
Character of Well (completed as Oil, Gas or Dry Hole) Dry Hole  
Date well completed 11-26-64 19\_\_  
Application for plugging filed 12-7-64 19\_\_  
Application for plugging approved 11-26-64 19\_\_  
Plugging commenced 11-26-64 19\_\_  
Plugging completed 11-26-64 19\_\_  
Reason for abandonment of well or producing formation Dry Hole

NORTH

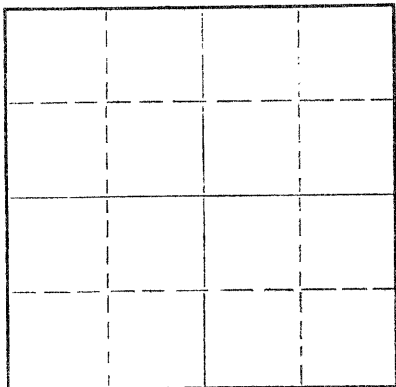

Locate well correctly on above  
Section Plat

If a producing well is abandoned, date of last production \_\_\_\_\_ 19\_\_  
Was permission obtained from the Conservation Division or its agents before plugging was commenced? Yes

Name of Conservation Agent who supervised plugging of this well Eldon Petty, Hays, Kansas  
Producing formation \_\_\_\_\_ Depth to top \_\_\_\_\_ Bottom \_\_\_\_\_ Total Depth of Well 2918 Feet  
Show depth and thickness of all water, oil and gas formations.

OIL, GAS OR WATER RECORDS

CASING RECORD

FORMATION	CONTENT	FROM	TO	SIZE	PUT IN	PULLED OUT

Describe in detail the manner in which the well was plugged, indicating where the mud fluid was placed and the method or methods used in introducing it into the hole. If cement or other plugs were used, state the character of same and depth placed, from \_\_\_\_\_ feet to \_\_\_\_\_ feet for each plug set.

Set Plug #1 at 540' with 25 sacks cement.  
Set Plug #2 at 240' with 25 sacks cement.  
Set Plug #3 at 30' with 25 sacks cement.

RECEIVED  
STATE CORPORATION COMMISSION  
12/10/64  
DEC 10 1964

CONSERVATION DIVISION  
Wichita, Kansas

(If additional description is necessary, use BACK of this sheet)  
Name of Plugging Contractor D & D Drilling Company, Inc.  
Address 307 Schweiter Building, Wichita, Kansas

STATE OF Kansas, COUNTY OF Sedgwick, ss.  
Glenn M. Dunne, Jr. (employee of owner) or (owner or operator) of the above-described well, being first duly sworn on oath, says: That I have knowledge of the facts, statements, and matters herein contained and the log of the above-described well as filed and that the same are true and correct. So help me God.

(Signature) Glenn M. Dunne, Jr.  
307 Schweiter Building, Wichita, Kansas  
(Address)

SUBSCRIBED AND SWORN TO before me this 7th day of December, 1964

My commission expires 11-18-66

Colleen Chapple  
Colleen Chapple  
Notary Public.



15-163-19333-00-00

ROTARY DRILLING LOG

OPERATOR:	D & D Drilling Co. & Raymond Oil Co.	COMMENCED:	11-22-64
CONTRACTOR:	D & D Drilling Company, Inc.	COMPLETED:	11-26-64
WELL:	Hilgers "B" No. 1	ELEVATION:	2184 RB
LOCATION:	Approx. NW SE NE Section 24-9S-19W		
COUNTY:	Rooks County, Kansas		

Formations	Depth	Remarks
Sand & Shale	797'	
Shale & Sand	1491'	
Shale	1559'	
Anhydrite	1602'	
Shale	2023'	
Shale & Lime	2710'	
Lime & Shale	2913'	
Rotary Total Depth	2918'	D & A

**RECEIVED**  
STATE CORPORATION COMMISSION  
DEC 10 1964

CONSERVATION DIVISION  
Wichita, Kansas

A F F I D A V I T


State of Kansas )  
                          ) SS  
County of Sedgwick)

I, Glenn M. Dunne, Jr., of lawful age, being duly and solemnly sworn on oath say: I am a resident of Wichita, Sedgwick County, Kansas, and I hereby know and on oath state that the above drilling log covering the Hilgers "B" No. 1, located in the Approx. NW SE NE Section 24-9S-19W, Rooks County, Kansas, is true and correct to the best of my knowledge and belief.

*Glenn M. Dunne, Jr.*  
Glenn M. Dunne, Jr.

Subscribed and sworn to before me this 7th day of December, 1964.

My Commission expires:

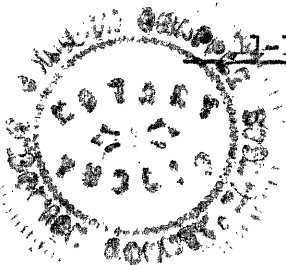

*Colleen Chapple*  
Colleen Chapple, Notary Public