


STATE OF KANSAS  
STATE CORPORATION COMMISSION

Give All Information Completely  
Make Required Affidavit  
Mail or Deliver Report to:  
Conservation Division  
State Corporation Commission  
800 Bitting Building  
Wichita, Kansas

WELL PLUGGING RECORD

NORTH

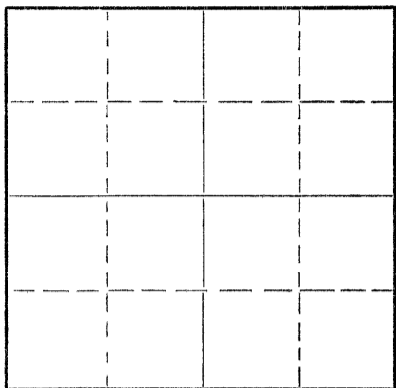

Locate well correctly on above  
Section Plat

Rooks County. Sec. 18 Twp. 9 Rge. 19 (E) W (W)  
Location as "NE/CNW $\frac{1}{4}$ /SW $\frac{1}{4}$ " or footage from lines SE NE SW  
Lease Owner Mallonee Drilling Company, Inc.  
Lease Name Marcotte Well No. 1  
Office Address 812 Central Bldg., Wichita 2, Kansas  
Character of Well (completed as Oil, Gas or Dry Hole) Dry Hole  
Date well completed May 24 19 52  
Application for plugging filed May 29 19 52  
Application for plugging approved May 23 19 52  
Plugging commenced May 24 19 52  
Plugging completed May 24 19 52  
Reason for abandonment of well or producing formation Well completed as a dry hole

If a producing well is abandoned, date of last production \_\_\_\_\_ 19\_\_\_\_  
Was permission obtained from the Conservation Division or its agents before plugging was commenced? Yes

Name of Conservation Agent who supervised plugging of this well Eldon Petty  
Producing formation None Depth to top \_\_\_\_\_ Bottom \_\_\_\_\_ Total Depth of Well 3605 Feet  
Show depth and thickness of all water, oil and gas formations.

OIL, GAS OR WATER RECORDS

CASING RECORD

FORMATION	CONTENT	FROM	TO	SIZE	PUT IN	PULLED OUT
				8-5/8	182'	None

Describe in detail the manner in which the well was plugged, indicating where the mud fluid was placed and the method or methods used in introducing it into the hole. If cement or other plugs were used, state the character of same and depth placed, from \_\_\_\_\_ feet to \_\_\_\_\_ feet for each plug set.

Mud to 182  
Wood Plug at 182 15 sks cement. Mud to 20'. Wood plug  
@ 20' 10 sks cement to surface.

(If additional description is necessary, use BACK of this sheet)

Name of Plugging Contractor Mallonee Drilling Company, Inc.  
Address 812 Central Bldg., Wichita 2, Kansas

STATE OF Kansas, COUNTY OF Sedgwick, ss.  
F. W. Mallonee (employee of owner) or (owner or operator) of the above-described well, being first duly sworn on oath, says: That I have knowledge of the facts, statements, and matters herein contained and the log of the above-described well as filed and that the same are true and correct. So help me God.

(Signature) F. W. Mallonee  
812 Central Bldg., Wichita 2, Kansas  
(Address)

SUBSCRIBED AND SWORN TO before me this 29th day of May, 19 52

My commission expires March 7, 1953

RECEIVED  
STATE CORPORATION COMMISSION  
JUN 2 1952  
Notary Public.

181-9-10  
19-16

15-163-02749-00-00

DRILLER'S LOG

#1 MARGOTTE

SE NE SW SEC. 18-98-19W  
Rooks County, Kansas

Commenced: May 8, 1952  
Completed: May 24, 1952

Elev. 2067 K.B.  
D & A

	<u>Description</u>	<u>Remarks</u>
0 to 10	Soil	
178	Shale and shells	182' (5 jts.) 8-5/8" 2 1/4" surface casing set at 178 with 125 sax
200	Shale and shells	
365	Shale	
1035	Shale, lime and salt	
1110	Sand, shale and shells	
1470	Shale and shells	
1515	Lime	
2070	Shale and lime	
2205	Lime with shale streaks	
2255	Shale, lime and iron pyrite	
2305	Shale	
3070	Lime and shale	
3130	Lime	
3270	Lime and shale	
3301	Shale	Odor and free oil 3246-71
3380	Lime	Odor and free oil 3335-30
		Odor and small show 3356-69
		Odor and small show 3372-80
3395	Lime and shale	
3465	Lime	
3495	Shale and lime	
3535	Conglomerate	
3547	Chert	
3577	Conglomerate	
3605	Lime	

TOPS:	Topoka	3031	(-964)
	Heebner	3240	(-1173)
	Toronto	3261	(-1194)
	Lansing-K.G.	3278	(-1201)
	Conglomerate	3536	(-1469)
	Arbuckle	3586	(-1519)

I certify that to the best of my knowledge and belief, the foregoing information is a true and accurate Driller's Log of the above-captioned well.

*E. F. Mallonee*  
E. F. Mallonee

**PLUGGING**  
FILE SEC 18-98-19W  
BOOK PAGE 19 LINE 26