


Give All Information Completely
Make Required Affidavit
Mail or Deliver Report to:
Conservation Division
State Corporation Commission
211 No. Broadway
Wichita, Kansas

WELL PLUGGING RECORD

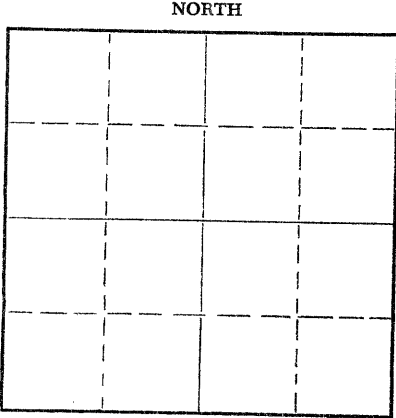

Locate well correctly on above
Section Plat

Rooks _____ County, Sec. 8 Twp. 9 Rge. 16 (W)
Location as "NE/CNW/SW" or footage from lines SW SW NW
Lease Owner Alkay Oil Company
Lease Name Pfannenstiel Well No. 1
Office Address 611 Kennedy Building, Tulsa, Oklahoma
Character of Well (completed as Oil, Gas or Dry Hole) Dry Hole
Date well completed January 31
Application for plugging filed January 30 (Orally) 19 56
Application for plugging approved January 30 (Orally) 19 56
Plugging commenced January 31 19 56
Plugging completed January 31 19 56
Reason for abandonment of well or producing formation Dry Hole

If a producing well is abandoned, date of last production _____ 19____
Was permission obtained from the Conservation Division or its agents before plugging was commenced? yes

Name of Conservation Agent who supervised plugging of this well Eldon Petty
Producing formation _____ Depth to top _____ Bottom _____ Total Depth of Well 3620 Feet
Show depth and thickness of all water, oil and gas formations.

OIL, GAS OR WATER RECORDS

CASING RECORD

FORMATION	CONTENT	FROM	TO	SIZE	PUT IN	PULLED OUT
		0	210	8 5/8	8 5/8	None

Describe in detail the manner in which the well was plugged, indicating where the mud fluid was placed and the method or methods used in introducing it into the hole. If cement or other plugs were used, state the character of same and depth placed, from _____ feet to _____ feet for each plug set.

From 3620' to 200' Heavy Rotary Mud
200' to 198' Set Plug
198' to 150' 1/2 Sack Hulls & 15 Sacks Cement
150' to 40' Heavy Rotary Mud
40' to 38' Set Plug
38' to 0' 1/2 Sack Hulls & 10 Sacks Cement

(If additional description is necessary, use BACK of this sheet)
Name of Plugging Contractor Badger Drillers, Inc.
Address Great Bend, Kansas


STATE OF OKLAHOMA, COUNTY OF TULSA, ss.
E. G. MOEHLKAMP (employee of owner) or (owner or operator) of the above-described well, being first duly sworn on oath, says: That I have knowledge of the facts, statements, and matters herein contained and the log of the above-described well as filed and that the same are true and correct. So help me God.

(Signature) E. G. Moehlkamp
611 Kennedy Building, Tulsa, Oklahoma
(Address)

SUBSCRIBED AND SWORN TO before me this 8th day of February, 19 56

Dorene Stark
Notary Public.

My commission expires March 28, 1957

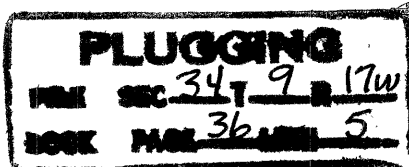

REC'D
2-14-56

Alkay Oil Company
 Pfannensteil #1
 SW-SW-NW, Section 34, T-9S, R-17W
 Rooks County, Kansas

Drilling started 1-21-56
 Drilling completed 1-31-56
 8 5/8" Casing cemented @ 210'

<u>From</u>	<u>To</u>	<u>Formation</u>	
0'	40'	Surface Sand	
40'	110'	Sand, Shale and Shells	
110'	210'	Shale	210' - 8 5/8" O.D. Spiral Weld set at 210' with 165 sacks
210'	930'	Shale and Shells	
930'	1060'	Sand	
1060'	1300'	Red Bed	
1300'	1348'	Shale	
1348'	1375'	Anhydrite	
1375'	1810'	Shale	
1810'	1900'	Shale and Shells	
1900'	3003'	Lime and Shale	
3003'	3095'	Lime	
3095'	3165'	Lime and Shale	
3165'	3505'	Lime	
3505'	3584'	Conglomerate	
3584'	3620'	Lime	Dry Hole

This is a certified copy of the Drillers Log as shown by the Daily Drillers Reports.

[Signature]
 BADGER DRILLERS, INC.

Subscribed and sworn to before me this 7th day of February, 1956.

[Signature]
 NOTARY PUBLIC

My commission expires:
 7-6-1959

PLUGGING
 FILE SEC 34 T 9 R 17W
 BOOK PAGE 36 LINE 5

2-14-56