

STATE OF KANSAS
STATE CORPORATION COMMISSION

WELL PLUGGING RECORD

Give All Information Completely
Make Required Affidavit
Mail or Deliver Report to:
Conservation Division
State Corporation Commission
212 No. Market
Wichita, Kansas

Rooks County. Sec. 11 Twp. 9S Rge. (E) 19W(W)

Location as "NE/CNW/SW" or footage from lines SE¹/₄ SW¹/₄ SE¹/₄

Lease Owner Birmingham - Bartlett Drilling Co.

Lease Name Ruder Well No. 2

Office Address 300 Kaufman Building, Wichita, Kansas, 67202

Character of Well (completed as Oil, Gas or Dry Hole) Oil Well

Date well completed June 4, 1951

Application for plugging filed October 8, 1968

Application for plugging approved October 9, 1968


Plugging commenced November 20, 1968

Plugging completed November 21, 1968

Reason for abandonment of well or producing formation Production declined to a point where well no longer economical to operate.

If a producing well is abandoned, date of last production November 19, 1968

Was permission obtained from the Conservation Division or its agents before plugging was commenced? Yes

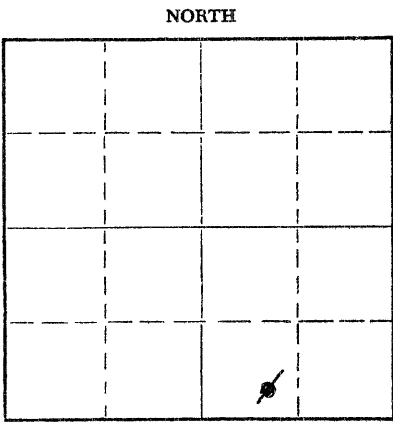

Locate well correctly on above Section Plat

Name of Conservation Agent who supervised plugging of this well Leo Massey

Producing formation Arbuckle Depth to top 3472' Bottom _____ Total Depth of Well 3475 Feet

Show depth and thickness of all water, oil and gas formations.

OIL, GAS OR WATER RECORDS

CASING RECORD

FORMATION	CONTENT	FROM	TO	SIZE	PUT IN	PULLED OUT
		0	219'	8-5/8"	219'	None
		0	3473'	5-1/2"	3477+'	None

Describe in detail the manner in which the well was plugged, indicating where the mud fluid was placed and the method or methods used in introducing it into the hole. If cement or other plugs were used, state the character of same and depth placed, from _____ feet to _____ feet for each plug set.

Spotted 10- Sacks cement at-- 3450' Thru-Tubing

Spotted tubing at 1400'-Mixed 17-Sks. Gel. Circulate to surface, Spot 15-Sks. Cement at 1400';- Spot Tubing at 700', Spot 15 Sks. cement, Spot tubing at ~~700'~~ 210'-Circulate cement to the base of cellar 3' below ground level;

Sun Cementing Company; Furnished all cement;

RECEIVED
STATE CORPORATION COMMISSION
DEC 2 1968
CONSERVATION DIVISION
Wichita, Kansas

(If additional description is necessary, use BACK of this sheet)

Name of Plugging Contractor Sun Oil Well Cementing Company, Inc.
Address Box 69, Hays, Kansas, 67601

STATE OF KANSAS, COUNTY OF SEDGWICK, ss.

Chas. H. Keevert, employee of operator & part owner (employee of owner) or (owner or operator) of the above-described well, being first duly sworn on oath, says: That I have knowledge of the facts, statements, and matters herein contained and the log of the above-described well as filed and that the same are true and correct. So help me God.

(Signature) Chas. H. Keevert
Route 1, 1806 Tracy Ln., Hutchinson, Kans., 67501
(Address)

SUBSCRIBED AND SWORN TO before me this 29th day of November 19 68

My commission expires November 29, 1970
Vivian F. Yinger
Vivian F. Yinger Notary Public.

Check for \$34.75 Plugging Fee covering Invoice No. 8870-W enclosed herewith.

15-163-21633-00-00

RUDDER NO. 2 WELL

Location: SE/4 SW/4 SE/4 Sec. 11-9S-19W
Rooks County, Kansas

Operator: Birmingham-Bartlett Drilling Co.

Contractor: Fred Drilling Co.

Surface Casing: 7 jts. 8-5/8" set @ 219'
w/175 sacks cement

Oil String: 111 jts. (3477.72) 5 1/2"
cemented at 3473' w/125 sacks
cement

Date Spudded: 5-19-51

Date Rotary Completion: 5-29-51

Total Depth: 3474'

Elevation: 2044' RB

T O P S R B

Anhydrite	1410 (+ 634)
Heebner	3186 (-1142)
Lansing-Kansas City	3226 (-1182)
Arbuckle	3472 (-1428)
Total Depth	3474 (-1430)

L O G

(Figures indicate bottom of formation)

Sand - shale	0 to 220
Cement	300
Shale and sand	925
Sand	1160
Shale	1410
Anhydrite	1441
Shale and shells	2075
Shale - lime	2224
Lime and shale	2460
Shale - lime	2545
Lime and shale	2745
Shale	2925
Shale and lime	3045
Lime - shale	3267
Lime	3347
Lime and shale	3474 T.D.

The undersigned, Robert F. Walters, hereby certifies that the above log is a true and correct log of the formation encountered in drilling the above noted well as reflected by the Daily Drilling Reports.

FRED DRILLING CO.

By Robert F. Walters

Subscribed and sworn to before me this 1st day of June 1951.

Mary L. Lawrence
Notary Public

My commission expires:

My Commission Expires Feb. 28, 1955

When drilling-in above well, it was deepened 1 foot to total depth of 3475'.

Birmingham - Bartlett Drilling Co.

RECEIVED
STATE CORPORATION COMMISSION
10/9/68
OCT 9 - 1968
CONSERVATION DIVISION
Wichita, Kansas