


15-163-02869-00-00

STATE OF KANSAS  
STATE CORPORATION COMMISSION

WELL PLUGGING RECORD

Give All Information Completely  
Make Required Affidavit  
Mail or Deliver Report to:  
Conservation Division  
State Corporation Commission  
800 Bitting Building  
Wichita, Kansas

Books \_\_\_\_\_ County. Sec. 11 Twp. 2s Rge. 19 (E) (W) (W)  
Location as "NE/CNW $\frac{1}{4}$ SW $\frac{1}{4}$ " or footage from lines NE/4 NE/4 SE/4  
Lease Owner Fred Drilling Co., et al  
Lease Name RUDER Well No. 1  
Office Address 509 Orpheum Building Wichita, Kansas  
Character of Well (completed as Oil; Gas or Dry Hole) Dry hole  
Date well completed 5-17 19 51  
Application for plugging filed (verbal) 5-17 19 51  
Application for plugging approved (verbal-5-17-51); written- 5-21 19 51  
Plugging commenced 5-17 19 51  
Plugging completed 5-17 19 51  
Reason for abandonment of well or producing formation - dry hole -

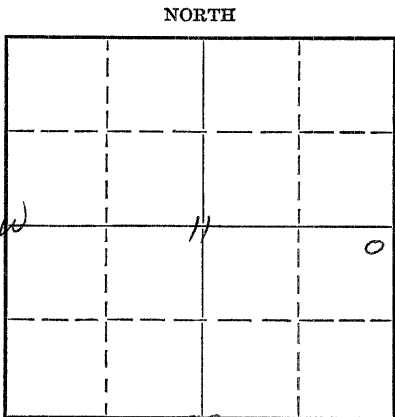

If a producing well is abandoned, date of last production \_\_\_\_\_ 19\_\_\_\_  
Was permission obtained from the Conservation Division or its agents before plugging was commenced? yes

Name of Conservation Agent who supervised plugging of this well Eldon Petty-Box 326-Hays, Kansas  
Producing formation \_\_\_\_\_ Depth to top \_\_\_\_\_ Bottom \_\_\_\_\_ Total Depth of Well 3576 Feet  
Show depth and thickness of all water, oil and gas formations.

OIL, GAS OR WATER RECORDS

CASING RECORD

Formation	Content	From	To	Size	Put In	Pulled Out
				Surface casing: 7 its. 8-5/8" set @ 139'		
				w/15 sacks cement and 1 sack Cal. Chloride.		
				No oil string run - D & A		

Describe in detail the manner in which the well was plugged, indicating where the mud fluid was placed and the method or methods used in introducing it into the hole. If cement or other plugs were used, state the character of same and depth placed, from \_\_\_\_\_ feet to \_\_\_\_\_ feet for each plug set.

Filled hole with heavy mud to 150' and cemented with 15 sacks of cement; set top plug @ 10' and cemented with 10 sacks of cement; pipe cut off 3' below level of ground.

RECEIVED  
STATE CORPORATION COMMISSION  
5/24/51  
MAY 24 1951  
CONSERVATION DIVISION  
Wichita, Kansas

(If additional description is necessary, use BACK of this sheet)

Correspondence regarding this well should be addressed to Fred Drilling Co.  
Address 509 Orpheum Building Wichita, Kansas

STATE OF Kansas, COUNTY OF Sedgwick, ss.  
Robert F. Walters (employee of owner) or (owner or operator) of the above-described well,  
being first duly sworn on oath, says: That I have knowledge of the facts, statements, and matters herein contained and the log of the above-described well as filed and that the same are true and correct. So help me God.

(Signature) Robert F. Walters  
509 Orpheum Building Wichita, Kansas  
(Address)

SUBSCRIBED AND SWORN to before me this 22 day of May 1951

My commission expires My Commission Expires Feb. 28, 1955 Mary L. Lawrence Notary Public.

23-5091-s 8-50-10M

PLUGGING  
FILE SEC-11 T 9 R 19 W  
BOOK PAGE 82 LINE 25

RUDER NO. 1 WELL

Location: NE/4 NE/4 SE/4 Sec. 11-28-19W  
Rooks County, Kansas

Spudded: 5-8-51

Operator: Fred Drilling Co.

Completed: 5-17-51

Contractor: Fred Drilling Co.

Elevation: 2062 FB

Surface Casings: 7 jts. 3-5/8" set @ 139'  
w/115 sacks cement and  
1 sack Cal. Chloride.

Oil String: None - B & A

T O P S K B

Anhydrite	1138 (+ 624)
Topoka	3013 (- 951)
Heehner	3224 (-1162)
Lansing-K.C.	3264 (-1202)
Conglomerate	3514 (-1452)
Simp. Shale	3527 (-1467)
Arbuckle	3565 (-1503)
Total Depth	3576 (-1514)

L O G

(Figures indicate bottom of formation)

Sand shale	0 to 141
Shale	230
Shale and sand	950
Sand	1160
Shale	1138
Anhydrite	1173
Shale and shells	2180
Shale - lime	2318
Lime - shale	2855
Shale	2949
Shale - lime	3028
Lime	3091
Lime - shale	3278
Lime	3500
Lime and shale	3576 T.D.

The undersigned Robert F. Walters of the Fred Drilling Co. hereby certifies that the above is a true and correct log of the formations encountered in drilling the Ruder #1 well as shown on the daily drilling reports.

RECEIVED

FRED DRILLING CO.

CORPORATION COMMISSION

MAY 25 1951

REGISTRATION DIVISION

By: Robert F. Walters

Subscribed and sworn before me  
this 22nd day of May, 1951.

Mary L. Lawrence  
Notary Public

My commission expires:

My Commission Expires Feb. 28, 1955

**PLUGGING**  
FILE SEC 11 T 9 R 19 W  
BOOK PAGE 13 LINE 25