


Give All Information Completely
Make Required Affidavit
Mail or Deliver Report to:
Conservation Division
State Corporation Commission
800 Bittling Building
Wichita, Kansas

WELL PLUGGING RECORD

15-163-00152-00-00

NORTH

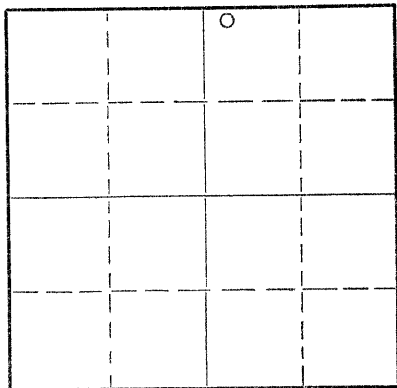

Locate well correctly on above
Section Plat

Rooks

County. Sec. 4 Twp. 9 Rge. (E) 19 (W)

Location as "NE/CNW/SW" or footage from lines C NW NW NE
Lease Owner Westgate-Greenland Oil Company
Lease Name McClellan Well No. 1
Office Address 1009 Central Building, Wichita 2, Kansas
Character of Well (completed as Oil, Gas or Dry Hole) oil
Date well completed May 3, 1948 19
Application for plugging filed March 23, 1953 19
Application for plugging approved March 23, 1953 19
Plugging commenced March 23, 1953 19
Plugging completed March 23, 1953 19
Reason for abandonment of well or producing formation oil depleted

If a producing well is abandoned, date of last production April 1 1952
Was permission obtained from the Conservation Division or its agents before plugging was commenced? yes

Name of Conservation Agent who supervised plugging of this well Mr. Petty
Producing formation _____ Depth to top _____ Bottom _____ Total Depth of Well _____ Feet
Show depth and thickness of all water, oil and gas formations.

OIL, GAS OR WATER RECORDS

CASING RECORD

FORMATION	CONTENT	FROM	TO	SIZE	PUT IN	PULLED OUT
surface		0	159	8 5/8"	158'11"	none
Arbuckle		0	3438	5 1/2"	3438	none

Describe in detail the manner in which the well was plugged, indicating where the mud fluid was placed and the method or methods used in introducing it into the hole. If cement or other plugs were used, state the character of same and depth placed, from _____ feet to _____ feet for each plug set.

Mixed 20 sacks mud and pumped into well
Set Halliburton plug at 158' and pumped 40 sacks
cement which filled to cellar base.
Plugged by Halliburton under supervision of Mr. Petty

(If additional description is necessary, use BACK of this sheet)

Name of Plugging Contractor Halliburton under supervision of Mr. Petty
Address _____

STATE OF Kansas, COUNTY OF Sedgwick, ss.
G. E. Bitler (employee of owner) or (owner or operator) of the above-described well, being first duly sworn on oath, says: That I have knowledge of the facts, statements, and matters herein contained and the log of the above-described well as filed and that the same are true and correct. So help me God.

(Signature) G. E. Bitler

1009 Central Building, Wichita 2, Kansas
(Address)


SUBSCRIBED AND SWORN TO before me this 7th day of April 1953

Esther Zinsell

My commission expires May 25, 1953.

Notary Public.

24-2675-S 2-52-20M

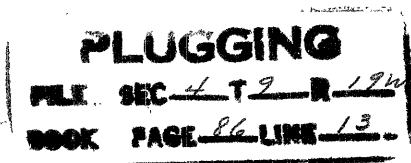

4/8/53

COMPANY: Westgate Greenland Oil Company
 CONTRACTOR: Jackson Drilling Corporation
 FARM: McClellan #1
 LOCATION: NW NW NE of Section 4-9-19W
 Rooks County, Kansas
 ELEVATION: 2008
 COMMENCED: April 23, 1948
 COMPLETED: May 3, 1948 - Rotary

0	to	30	Surface clay
30	to	60	Sand
60	to	70	Lime
70	to	156	Shell & Shale
156	to	370	Sand shell
370	to	955	Shale & Shells
955	to	1155	Sand
1155	to	1250	Shells & shale
1250	to	1430	Red Bed
1430	to	1475	Anhydrite
1475	to	1980	Shale & shells
1980	to	2065	Shale & lime shells
2065	to	3355	Lime & shale
3355	to	3410	Lime
3410	to	3442	Lime & shale
3442	to	3444	T. D. - Rotary
		3449	T. D. Cardwell

Set 158' 11" 8 5/8" casing - Cemented with 100 sacks cement.

Set 5 1/2" casing at 3438 - Cemented with 65 sacks cement.

Top - Arbuckle 3442

Acidized with 500 gallons acid

CERTIFICATE

I, Clare A. Stewart, do hereby certify that the above and foregoing is a true and correct copy of log of the McClellan #1, Section 4-9-19W, Rooks County, Kansas as reflected by files of the Jackson Drilling Corporation.

FILE DIVISION

Clare A. Stewart

Suscribed and sworn to before me, a Notary Public, within and for Johnson County, Kansas, this 19th day of May, 1948.

Dorothy J. Wilson

My Commission expires November 30, 1950

