15-163-21053-00-00

FORM CP-4

STATE OF KANSAS
STATE CORPORATION COMMISSION

Give All Information Completely
Make Required Affidavit
Mail or Deliver Report to
Conservation Division
State Corporation Comm.
245 North Water
Wichita, KS 67202

SW 4 25-8S-18W

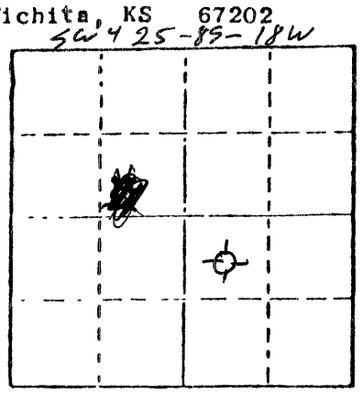

Locate well correctly on above Section Plat

WELL PLUGGING RECORD

Rooks County. Sec. 25 Twp. 8S Rge. 18 ~~E~~/W

Location as "NE/CNW¼SW¼" or footage from lines NW SE SW/4

Lease Owner George P. Crawford

Lease Name Bird Well No. #2

Office Address 926 4th Street Natoma, Kansas 67651

Character of Well (Completed as Oil, Gas or Dry Hole) Dry Hole

Date Well completed June 18 19 80

Application for plugging filed June 18 19 80

Application for plugging approved June 18 19 80

Plugging commenced June 18, 9:00 P.M. 19 80

Plugging completed June 18, 10:30 P.M. 19 80

Reason for abandonment of well or producing formation No Commercial Production

If a producing well is abandoned, date of last production 19

Was permission obtained from the Conservation Division or its agents before plugging was commenced? yes

Name of Conservation Agent who supervised plugging of this well Marion Schmidt

Producing formation Depth to top Bottom Total Depth of Well

Show depth and thickness of all water, oil and gas formations.

OIL, GAS OR WATER RECORDS

CASING RECORD

FORMATION	CONTENT	FROM	TO	SIZE	PUT IN	PULLED OUT
surface casing	common	0	204.81'	8 5/8"	204.81'	0

Describe in detail the manner in which the well was plugged, indicating where the mud flui was placed and the method or methods used in introducing it into the hold. If cement or othe plugs were used, state the character of same and depth placed, from feet to feet for each plug set.

Plug #1 @ 750' with 60 sxs
Plug #2 @ 200' with 30 sxs
Plug #3 @ 40' with 1 sx hulls & 10 sxs
5 sxs in rathole
50-50 poz

DEC 24 1980
Dec 24, 1980
CONSERVATION DIVISION
Wichita, Kansas

(If additional description is necessary, use BACK of this sheet)

Name of Plugging Contractor Pioneer Drilling Company, Inc.
308 West Mill Plainville, Kansas 67663

STATE OF Kansas COUNTY OF Rooks, ss.

George P. Crawford (~~employee of owner~~) or (owner or operator of the above-described well, being first duly sworn on oath, says: That I have knowledge of the facts, statements, and matters herein contained and the log of the above-described well as filed and that the same are true and correct. So help me God.

(Signature) George P. Crawford
Natoma, KS 67651
(Address)

SUBSCRIBED AND SWORN TO before me this 22nd day of December, 19 80

VICKI NORTHUP
Rooks County, Ks.
My Appt. Exp. June 2, 1984

Vicki Northup
Notary Public.

My commission expires June 2, 1984

15-163-21053-00-00

WELL LOG

OPERATOR: George P. Crawford

WELL NAME: Bird #2 LOCATION: NW SE SW/4 25-8S-18W

COUNTY: Rooks STATE: Kansas

WELL COMMENCED: June 11, 1980 WELL COMPLETED: June 18, 1980

ELEVATION: 2023' K.B. TOTAL DEPTH: 3068'

PRODUCTION: D & A RIG NO: #1

CASING - 8-5/8": 204.81' of used 28# cemented with 100 sxs common 2% gel 3% cc

5-1/2": none

ALL MEASUREMENTS TAKEN FROM THE TOP OF ROTARY BUSHING:

FROM	TO	FORMATION	DEVIATION FROM VERTICAL	REMARKS:
0'	740'	cement, shale and sand		
740'	1345'	sand and shale		
1345'	1362'	Anhydrite		
1362'	1386'	Anhydrite		
1386'	1542'	shales	1449' - 1/2 degree	
1542'	2005'	shale		
2005'	2197'	shales and limes		
2197'	2227'	shales and limes	2227' - 1/2 degree	
2227'	2256'	shales and limes		
2256'	2455'	shale and lime		
2455'	2605'	shale and limes		
2605'	2727'	shales and limes		
2727'	2872'	shale and lime		
2872'	2995'	limes and shale		
2995'	3068'	lime and shale		
3068'	3068'			

STATE OF KANSAS
COUNTY OF

The undersigned hereby certifies that to the best of his knowledge and belief, the above facts are true and correct

PIONEER DRILLING CO., INC.

By Roger L. Cornes

SUBSCRIBED AND SWORN TO, BEFORE ME, This 30th day of June, 1980.

Connie Jo Austin
NOTARY PUBLIC

RECEIVED
STATE CORPORATION COMMISSION
JUL 1 1980
CONSERVATION DIVISION
Wichita, Kansas

JUL 1, 1980

CONNIE JO AUSTIN
STATE NOTARY PUBLIC
ROOKS COUNTY, KS.
My Appt. Exp. 4-26-83
KANSAS