

15-163-02390-00-00
WELL PLUGGING RECORD


STATE OF KANSAS
STATE CORPORATION COMMISSION

Give All Information Completely
Make Required Affidavit
Mail or Deliver Report to:
Conservation Division
State Corporation Commission
800 Biting Building
Wichita, Kansas

OR
FORMATION PLUGGING RECORD

Strike out upper line
when reporting plug-
ging off formations.

NORTH

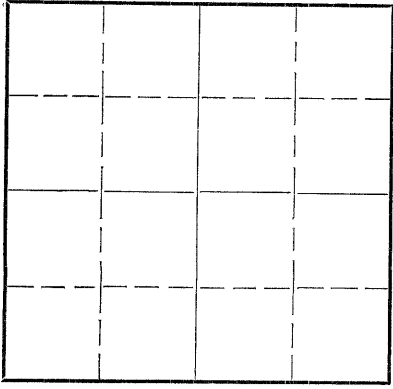

Locate well correctly on above
Section Plat

Rooks County. Sec. 26 Twp. 8 Rge. 18 (X) W. (W)
Location as "NE 1/4 NW 1/4 SW 1/4" or footage from lines C NE NE
Lease Owner Bishop Oil Company
Lease Name Hazen Well No. 1
Office Address 1011 Brown Bldg., Wichita, Kansas
Character of Well (completed as Oil, Gas or Dry Hole) Dry Hole
Date well completed June 21 19 43
Application for plugging filed June 20 19 43
Application for plugging approved June 20 19 43
Plugging commenced June 20 19 43
Plugging completed June 21 19 43
Reason for abandonment of well or producing formation Dry

If a producing well is abandoned, date of last production ---- 19
Was permission obtained from the Conservation Division or its agents before plugging was com-
menced? Yes

Name of Conservation Agent who supervised plugging of this well Bert Stafford
Producing formation Arbuckle Lime Depth to top 3443 Bottom ---- Total Depth of Well 3460 Feet
Show depth and thickness of all water, oil and gas formations.

OIL, GAS OR WATER RECORDS

CASING RECORD

Formation	Content	From	To	Size	Put In	Pulled Out
Post rock	Barren	0	60			
Shale & surface sand	Fresh water	60	100			
Shale	Barren	100	550			
Sand and Shale	Dakota Water	550	1050			
Shale and Red Beds	Barren	1050	1290			
See log attached				8 5/8	1290	None

Describe in detail the manner in which the well was plugged, indicating where the mud fluid was placed and the method or methods used in introducing it into the hold. If cement or other plugs were used, state the character of same and depth placed, from ---- feet to ---- feet for each plug set.

Filled hole with heavy mud from 3460' to 1290'. Bridged hole with wood plug at 1290' and cemented to 1255'. Filled hole with heavy mud to 170' and bridged hole with wood plug and cemented to 140'. Filled hole with mud to 30'. Bridged hole and cemented to a depth of 10' or bottom of cellar.

(If additional description is necessary, use BACK of this sheet)

Correspondence regarding this well should be addressed to Bishop Oil Company
Address 1011 Brown Bldg., Wichita, Kansas

STATE OF Kansas, COUNTY OF Sedgwick, ss,
Carl Toee (employee of owner) of the above-described well,

being first duly sworn on oath, says: That I have knowledge of the facts, statements, and matters herein contained and the log of the above-described well as filed and that the same are true and correct. So help me God.

(Signature) Carl Toee
1011 Brown Bldg., Wichita, Kansas
(Address)

SUBSCRIBED AND SWORN TO before me this 29th day of June

My commission expires April 25, 1946

Notary Public

15-163-62390-00-00

Bishop Oil Company

No. 1 Hazen - C NE NE $\frac{1}{4}$ 26-8-18W
Rooks County, Kansas
Elevation: 1992 D.F.

Started: May 31, 1943
Completed: June 21, 1943
Total Depth: 3460'

CASING RECORD

1290 feet 8 5/8" Casing cemented with 300 sacks.

DRILLERS LOG

Post rock	0' - 60'
Shale	550
Sand	615
Shale	710
Sand	725
Sand & Shells	760
Shale & Lime	840
Shale	860
Sand	1015
Shale	1050
Red Rock	1290
Red Bed	1315
Anhydrite	1345
Red Bed & Shale	1480
Red Rock	1525
Shale	1655
Shale & Shells	1755
Shale & Salt	1795
Shale & Shells	1960
Lime	1985
Shale	2005
Shale & Lime	2190
Lime	2265
Shale	2285
Lime	2505

Lime & Shale	2610'
Shale & Shells	2880
Shale & Lime	3054
Lime	3112
Lime & Shale	3130
Lime	3297
Broken Lime	3305
Lime	3321
Sand & Lime	3324
Lime	3379
Shale	3413
Conglomerate	3446
Lime	3460 T.D.

Dry & abandoned

Geol. Tops

Anhy.	1315
Dodge	3133
Lansing	3151
Chert Cong.	3411
Arb.	3443
SSO	3052-62
"	3077-83
Fair SO	3191-95
" "	3201-07
" "	3225-28
Slight	3345-48 in core

No show in Arbuckle

6-30-43

I hereby certify that the foregoing log is to the best of my knowledge and belief, true and correct.

SHARON DRILLING COMPANY, INC.,

By D. S. CATES (Signed)

State of Kansas }
County of Sedgwick } ss.

Subscribed and sworn to before me a Notary Public, in and for said State and County, this 23 day of June, 1943.

EMMA SCHIDLowsky (Signed)
Notary Public

My commission expires:

May 4, 1947

(NOTARIAL SEAL)

26 8 180
79 58