


15-163-02592-00-00  
WELL PLUGGING RECORD

Give All Information Completely  
Make Required Affidavit  
Mail or Deliver Report to:  
Conservation Division  
State Corporation Commission  
211 No. Broadway  
Wichita, Kansas

Rooks County. Sec 33 Twp. 8S Rge. 19W (E) (W)  
Location as "NE/CNW/SW" or footage from lines NW NW NE  
Lease Owner Christie-Stewart Drilling Company  
Lease Name Lowry Well No. 1  
Office Address 611 Union Center  
Character of Well (completed as Oil, Gas or Dry Hole) Dry Hole  
Date well completed March 14, 19 63  
Application for plugging filed March 14, 19 63  
Application for plugging approved March 14, 19 63  
Plugging commenced March 14, 19 63  
Plugging completed March 14, 19 63  
Reason for abandonment of well or producing formation Non-productive

NORTH

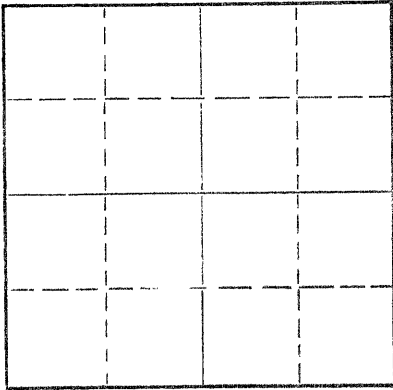

Locate well correctly on above  
Section Plat

If a producing well is abandoned, date of last production 19  
Was permission obtained from the Conservation Division or its agents before plugging was commenced? yes

Name of Conservation Agent who supervised plugging of this well Eldon Petty  
Producing formation - Depth to top - Bottom - Total Depth of Well 3467 Feet  
Show depth and thickness of all water, oil and gas formations.

OIL, GAS OR WATER RECORDS

CASING RECORD

FORMATION	CONTENT	FROM	TO	SIZE	PUT IN	PULLED OUT
				10 3/4"	175'	None

Describe in detail the manner in which the well was plugged, indicating where the mud fluid was placed and the method or methods used in introducing it into the hole. If cement or other plugs were used, state the character of same and depth placed, from feet to feet for each plug set.

Fill hole with heavy mud. Set 25 sx cement at 600', 25 sx cement at 181', and 10 sx at 40' to top.

RECEIVED  
STATE CORPORATION COMMISSION

MAR 21 1963

CONSERVATION DIVISION  
Wichita, Kansas

3/21/63

(If additional description is necessary, use BACK of this sheet)

Name of Plugging Contractor Halliburton Company  
Address Hays, Kansas

STATE OF KANSAS, COUNTY OF SEDGWICK, ss.  
ROBERT C. LEWELLYN (employee of owner) or (XXXXXXXXXX) of the above-described well, being first duly sworn on oath, says: That I have knowledge of the facts, statements, and matters herein contained and the log of the above-described well as filed and that the same are true and correct. So help me God.

(Signature) Robert C. Lewellyn  
611 Union Center, Wichita, Kansas  
(Address)

SUBSCRIBED AND SWORN to before me this 19th day of Marcy, 1963

My commission expires January 19, 1964

Patricia Hotmar  
Patricia Hotmar Notary Public.



K-163-02592-00-00

WELL LOG

Company:	Christie-Stewart Drilling Co.	Sec:	33-8S-19W
Farm:	Lowry	Loc:	NW NW NE
Rig:	No. 1	County:	Rooks
Total Depth:	3467	State:	Kansas
Comm:	3-5-63	Comp:	3-14-63
Contractor:	Christie-Stewart Drilling Co.	Elevation:	22014 KB
Casing:	10 3/4" @ 181 KBM/175 SX	Production:	D&A

240'	Soils, clays & surface material.	3250'	Shale
910'	Broken water sd.	3264'	Cherty limestone
1456'	Shale, shells	3272'	Shale
1492'	Anhydrite	3284'	Tan fossiliferous limestn.
1825'	Shale	3293'	Shale
1900'	Limestone	3334'	Tan limestone, show oil
2410'	Broken limestone and shale	3349'	Shale
2600'	Broken limestone	3363'	White limestone
2920'	Broken shale and sand	3381'	Limestone and shale
2950'	Shale	3396'	Dense Limestone
3100'	Broken limestone	3404'	Shale
3174'	White cherty, limestone	3419'	White limestone
3198'	Shale	3459'	Shale & Cong.
3215'	Broken limestone	3467'	Dolomite
3241'	White limestone, SS0.	3467'	TD

FORMATION TOPS

Heebner	3174'	(-1160')
Toronto	3198'	(-1184')
Lansing	3215'	(-1201')
Base Kansas City	3419'	(-1405')
Arbuckle	3459'	(-1445')
TD	3467	(-1453')

DRILL STEM TESTS

Test Number 1 - March 13, 1963, 3296-3312, 30 Min. Rec.  
 50' Sit. Wtr., IFP 0%, FFP 35%, BHP 910#, in 15 Min.

RECEIVED  
 STATE CORPORATION COMMISSION

MAR 21 1963

3/21/63

CONSERVATION DIVISION  
 Wichita, Kansas