

STATE OF KANSAS
STATE CORPORATION COMMISSION


15-163-21466-00-02

WELL PLUGGING RECORD

Give All Information Completely
Make Required Affidavit
Mail or Deliver Report to
Conservation Division
State Corporation Comm.
245 North Water
Wichita, KS 67202

Rooks County, Sec. 33 Twp. 8S Rge. 19 E/W
Location as "NE/CNW $\frac{1}{4}$ SW $\frac{1}{4}$ " or footage from lines
SE SE SW

Lease Owner Frontier Oil Company
Lease Name Cerrow Well No. 3 WD
Office Address 1720 Ks St Bank Bldg., Wichita, Ks 67202
Character of Well (Completed as Oil, Gas or Dry Hole)
ATTEMPTED WD OF OLD DRY HOLE

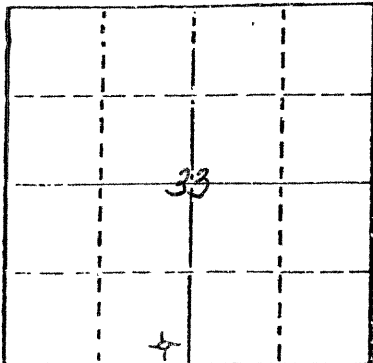

Locate well correctly on above
Section Plot

Date Well completed July 30 1981
Application for plugging filed January 08 1982
Application for plugging approved January 18 1982
Plugging commenced January 22 1982
Plugging completed January 22 1982
Reason for abandonment of well or producing formation

Hit bridge @680' / could not penetrate/Abdn loc
If a producing well is abandoned, date of last production
n/a 19

Was permission obtained from the Conservation Division or
its agents before plugging was commenced? yes

Name of Conservation Agent who supervised plugging of this well Dennis Hamel
Producing formation n/a Depth to top n/a Bottom n/a Total Depth of Well 680'
Show depth and thickness of all water, oil and gas formations.

OIL, GAS OR WATER RECORDS

CASING RECORD

FORMATION	CONTENT	FROM	TO	SIZE	PUT IN	PULLED OUT
OLD INFORMATION				8"	1440'	-0-

Describe in detail the manner in which the well was plugged, indicating where the mud fluid
was placed and the method or methods used in introducing it into the hold. If cement or other
plugs were used, state the character of same and depth placed, from _____ feet to
_____ feet for each plug set.

Used 235 sx 50/50 Poz/4% Gel, 3% CC

Pumped down to 680' w/cement and circulated cement to
surface. Topped off with 10 sx cmt

(If additional description is necessary, use BACK of this sheet)

Name of Plugging Contractor Allied Cementing Co., Inc.

STATE OF Kansas COUNTY OF Sedgwick, ss.
George A. Angle (employee of owner) (owner or operator)

of the above-described well, being first duly sworn on oath, says: That I have knowledge of
the facts, statements, and matters herein contained and the log of the above-described well
as filed and that the same are true and correct. So help me God.

(Signature)

George A. Angle

(Address)

SUBSCRIBED AND SWORN TO before me this 19th day of February, 19 82

Jean Stocks

Notary Public.

My commission expires 5-14-85



RCW 2/22/82