


15-163-00328-00-00

STATE OF KANSAS
STATE CORPORATION COMMISSION

WELL PLUGGING RECORD

Give All Information Completely
Make Required Affidavit
Mail or Deliver Report to:
Conservation Division
State Corporation Commission
800 Bitting Building
Wichita, Kansas

Rooks County. Sec. 14 Twp. 8 Rge. 19 (W)
Location as "NE/CNW 1/4 SW 1/4" or footage from lines NE SW SW
Lease Owner National Cooperative Refinery Association
Lease Name Hance Well No. 1
Office Address 820 Union National Bank Bldg.
Character of Well (completed as Oil, Gas or Dry Hole) Dry Hole
Date well completed July 13, 19 51
Application for plugging filed July 13, 19 51
Application for plugging approved July 14, 19 51
Plugging commenced July 14, 19 51
Plugging completed July 14, 19 51
Reason for abandonment of well or producing formation Dry

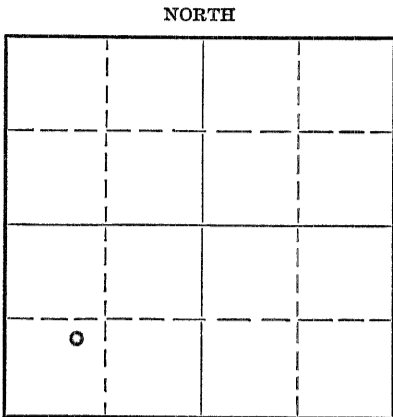

Locate well correctly on above
Section Plat

If a producing well is abandoned, date of last production 19
Was permission obtained from the Conservation Division or its agents before plugging was commenced? Yes

Name of Conservation Agent who supervised plugging of this well Mr. Eldon Petty
Producing formation Depth to top Bottom Total Depth of Well 3400 Feet
Show depth and thickness of all water, oil and gas formations.

OIL, GAS OR WATER RECORDS

CASING RECORD

Formation	Content	From	To	Size	Put In	Pulled Out
				8 5/8"	194'	Cemented

Describe in detail the manner in which the well was plugged, indicating where the mud fluid was placed and the method or methods used in introducing it into the hole. If cement or other plugs were used, state the character of same and depth placed, from feet to feet for each plug set.

Filled hole with heavy mud from 3400' to 180'; Set Plug.
Dumped 15 sacks cement. Filled hole with heavy mud to 40'.
Set plug. Dumped 15 sacks cement on up to base of cellar.

RECEIVED
STATE CORPORATION COMMISSION
JUL 20 1951
CONSERVATION DIVISION
Wichita, Kansas

17-28-51

(If additional description is necessary, use BACK of this sheet)

Correspondence regarding this well should be addressed to National Cooperative Refinery Association
Address 820 Union National Bank Building

STATE OF Kansas, COUNTY OF Sedgwick, ss.
W. Jean La Coss (employee of owner) or (owner or operator) of the above-described well,
being first duly sworn on oath, says: That I have knowledge of the facts, statements, and matters herein contained and the log of the above-described well as filed and that the same are true and correct. So help me God.

(Signature) W. Jean La Coss
(Address)

SUBSCRIBED AND SWORN TO before me this 19 day of July, 19 51

Lenna R. Lax
Notary Public.

My commission expires March 30, 1955

23-5091-s 8-50-10M

PLUGGING
FILE DEC 14 1951
BOOK PAGE 95 LINE 25

CONTRACTOR'S WELL LOG

COMPANY: National Cooperative Refinery Association
 CONTRACTOR: Musgrove Petroleum Corporation
 FARM: Hance #1
 LOCATION: NE/4 SW/4 SW/4, Section 14-T8S-R19W
 Rocks County, Kansas
 COMMENCED: June 29, 1951
 COMPLETED: July 12, 1951

0	5	Cellar
5	50	Clay
50	80	Sand
80	175	Shale
175	590	Shale and shells
590	710	Sand and shells
710	950	Shale and shells
950	1195	Sandy shale and shells
1195	1275	Shale and shells
1275	1310	Red bed
1310	1330	Chalf and Anhydrite
1330	1350	Anhydrite
1350	1490	Red bed and shale
1490	1910	Shale and shells
1910	2230	Shale and lime
2230	2340	Shale and shells
2340	2460	Lime and shale
2460	2555	Shale and shells
2555	2980	Lime and shale
2980	3020	Cherty lime
3020	3187	Lime
3187	3251	Lime and shale
3251	3286	Lime
3286	3400	Lime and shale
	3400	Rotary Total Depth

Set 19 1/2' of 6-5/8" surface casing, cemented with 160 sacks.
 Dry and Abandoned.

STATE OF KANSAS)
) SS.
 COUNTY OF SEDGWICK)

I, GORDON L. KOELLING, do hereby certify that the above and foregoing is a true and correct copy of the log of Hance #1, Sec. 14-8S-19W, Rocks County, Kansas, as reflected by files of the Musgrove Petroleum Corporation.

MUSGROVE PETROLEUM CORPORATION
 By Gordon L. Koelling
 Secretary

Subscribed and sworn to before me a Notary Public, within and for Sedgwick County, Kansas, this 19th day of July, 1951.

Gordon L. Koelling
 Notary Public

My commission expires: 12/5/51

PLUGGING
 FILE SEC 14-8-19W
 BOOK PAGE 98 75

RECEIVED
 STATE CORPORATION COMMISSION
 JUL 23 1951
 CONSERVATION DIVISION
 Wichita, Kansas