

15-163-02392-0000


STATE OF KANSAS
STATE CORPORATION COMMISSION

WELL PLUGGING RECORD

Give All Information Completely
Make Required Affidavit
Mail or Deliver Report to:
Conservation Division
State Corporation Commission
800 Bitting Building
Wichita, Kansas

OR
FORMATION PLUGGING RECORD Strike out upper line when reporting plugging off formations.

ROOKS County. Sec. 15 Twp. 8 Rge. 19 (E) (W) est
Location as "NE 1/4 NW 1/4 SW 1/4" or footage from lines. SW SW SE
Lease Owner BEN F. BRACK OIL CO INC.
Lease Name BURTON Well No. 1
Office Address 309-10 BROWN BLDG. WICHITA, KANSAS
Character of Well (completed as Oil, Gas or Dry Hole) DRY HOLE
Date well completed 7-17 19 49
Application for plugging filed 7-17-49 19 49
Application for plugging approved 7-17 19 49
Plugging commenced 7-17 19 49
Plugging completed 7-17 19 49
Reason for abandonment of well or producing formation dry hole

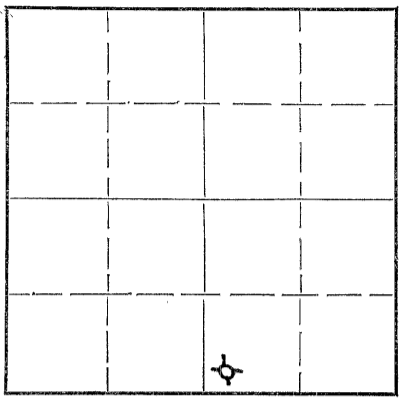

Locate well correctly on above Section Plat

If a producing well is abandoned, date of last production 19
Was permission obtained from the Conservation Division or its agents before plugging was commenced? YES

Name of Conservation Agent who supervised plugging of this well C.D. STOUGH
Producing formation Depth to top Bottom Total Depth of Well 3466 Feet
Show depth and thickness of all water, oil and gas formations.

OIL, GAS OR WATER RECORDS

CASING RECORD

Formation	Content	From	To	Size	Put In	Pulled Out
SAND, SURFACE SOIL CLAY	DRY	0	198	8 5/8	198	none

Describe in detail the manner in which the well was plugged, indicating where the mud fluid was placed and the method or methods used in introducing it into the hole. If cement or other plugs were used, state the character of same and depth placed, from 198 feet to 30 feet for each plug set.

GUNNED PITS AND LOADED HOLE WITH HEAVY MUD TO BASE OF SURFACE PIPE, PUT PLUG AT 198' AND DUMPED 15 SAX OF CEMENT ON TOP OF SAME: FILLED HOLE UP TO THIRTY FEET WITH MUD, PLACED PLUG AT 30 FEET AND DUMPED 10 SAX OF CEMENT ON TOP OF SAME.

RECEIVED
Conservation Div.
JUL 27 1949
STATE CORPORATION
COMMISSION
KANSAS

(If additional description is necessary, use BACK of this sheet)
Correspondence regarding this well should be addressed to BEN F. BRACK OIL CO INC.
Address 309-10 BROWN BLDG. WICHITA, KANSAS.

7-27-49

STATE OF KANSAS, COUNTY OF SEDGWICK, ss.
LELAND E. BRACK (employee of owner) or (owner or operator) of the above-described well, being first duly sworn on oath, says: That I have knowledge of the facts, statements, and matters herein contained and the log of the above-described well as filed and that the same are true and correct. So help me God.

(Signature) Leland E. Brack
GREAT BEND KANSAS (Address)

SUBSCRIBED AND SWORN to before me this 19 day of July, 19 49

My commission expires Nov. 26 - 1952
Bessie Merrill Notary Public.

PLUGGING
FILE NO. 15-1-8-1949
DATE FILED 107 JUN 3

BEN F. BRACK OIL COMPANY, INC.
309-10 Brown Building
Wichita, Kansas

BURTON # 1

SW SW SE 15-8S-19W
Rooks County, Kansas

WELL LOG

Comm: 7-5-49

Comp: 7-¹⁷18-49

TOTAL DEPTH:

3467

cellar	5
shale- rock	45
shale	198
surface soil & shells	600
shale	700
shale-shells	815
shale-sand, hard streaks	1115
red bed, iron	1145
red bed	1350
red bed, shale, sand streaks	1375
lime-anhydrite	1420
shale & shells	1590
shale	1785
shale & shells	1800
shale & lime	1870
shale-lime	2005
shale & lime	2092
lime & shale	2210
shale - lime	2335
shale & lime	2425
lime & shale	2525
shale - lime	2610
shale-lime	2670
shale- lime	2745
shale - lime	2855
shale & lime	2990
lime & shale	3055
shale - lime	3100
lime & shale	3155
lime	3200
lime	3250
lime	3358
lime	3310
lime	3350
lime	3415
lime shale, sand	3455
lime	3467

TOTAL DEPTH

3467

To the best of my knowledge, the above is a true and correct copy of the formations and where found.

BEN F. BRACK OIL COMPANY, INC.

By

Lucille S. Olson

President

WITNESS:

Lucille S. Olson

Dated: July 19, 1949

