

15-163-62535-00-00
WELL PLUGGING RECORD

OR

FORMATION PLUGGING RECORD

Strike out upper line
when reporting plug-
ging off formations.

			■

Rooks County. Sec. 16 Twp. 8 Rge. 19 (X) (W)
Location as "NE¼NW¼SW¼" or footage from lines S.W. S.E. S.E.
Lease Owner. Northern Pump Co.
Lease Name. Peterson "B" Well No. 1
Office Address. 1910 Broadway, Great Bend, Kansas
Character of Well (completed as Oil, Gas or Dry Hole) Dry Hole
Date well completed 8-20-48 19
Application for plugging filed 8-20-48 19
Application for plugging approved 8-20-48 19
Plugging commenced 8-20-48 19
Plugging completed 8-20-48 19
Reason for abandonment of well or producing formation Dry Hole

If a producing well is abandoned, date of last production.....19.....
Was permission obtained from the Conservation Division or its agents before plugging was commenced?.....Yes.....

OIL, GAS OR WATER RECORDS

CASING RECORD

[illegible]

Hole was filled with heavy rotary mud to 155'. Plug set with 15 sacks cement. Mud on top to 30 ft., another plug set at 30 ft., 10 sacks on top of it.

(If additional description is necessary, use BACK of this sheet)

Correspondence regarding this well should be addressed to.....
Address.....

STATE OF Kansas, COUNTY OF Barton, ss.
Chas. J. Beu (employee of owner) or (owner or operator) of the above-described well,
 being first duly sworn on oath, says: That I have knowledge of the facts, statements, and matters herein contained and the log of the above-described well as filed and that the same are true and correct. So help me God.

(Signature)

(Address)

SUBSCRIBED AND SWORN to before me this 23rd day of August (Address) 10 48

My commission expires March 10, 1952.

Notary Public.

22-2625 2-48-15M
PLUGGING
FILE SEC 16 T 8 R 19W
BOOK PAGE 51 LINE 14

15-163-02535-00-00

H. & H. Drilling Co.
Box 54
Wichita, Kansas


Peterson "B" #1
SW SE SE 16-8-19W
Rooks County, Kansas

EL 2026 D. F.

TOTAL DEPTH: 3520
Commenced: 8-11-48
Completed: 8-20-48
Casing: 8 5/8" -- 155' -- 100 sacks cement

Figures indicate bottom of formation:

0	to	100	Clay
100		135	Sand
135		155	Shale
155		650	Shale and sand
650		1110	Shale, shells, and sand
1110		1510	Shale and shells
1510		1835	Shale
1835		2004	Shale
2004		2130	Shale and lime
2130		2315	Lime
2315		2435	Shale and lime
2435		2535	Shale and shells
2535		2665	Shale
2665		2800	Lime and shale
2800		2880	Shale and shells
2880		2975	Shale
2975		3090	Lime
3090		3175	Broken Lime
3175		3235	Lime
3235		3258	Lime
3258		3280	Lime
3280		3335	Lime
3335		3382	Lime
3382		3435	Lime
3435		3475	Lime
3475		3520	Lime
3520			Rotary Total Depth

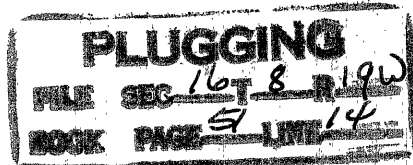


8-25-48

STATE CORPORATION COMMISSION
CONSERVATION DIVISION

800 Bitting Bldg.
Wichita 2, Kansas

15-163-02535-00-00

Township 8 South, Range 19 West, County Rooks, Pool _____

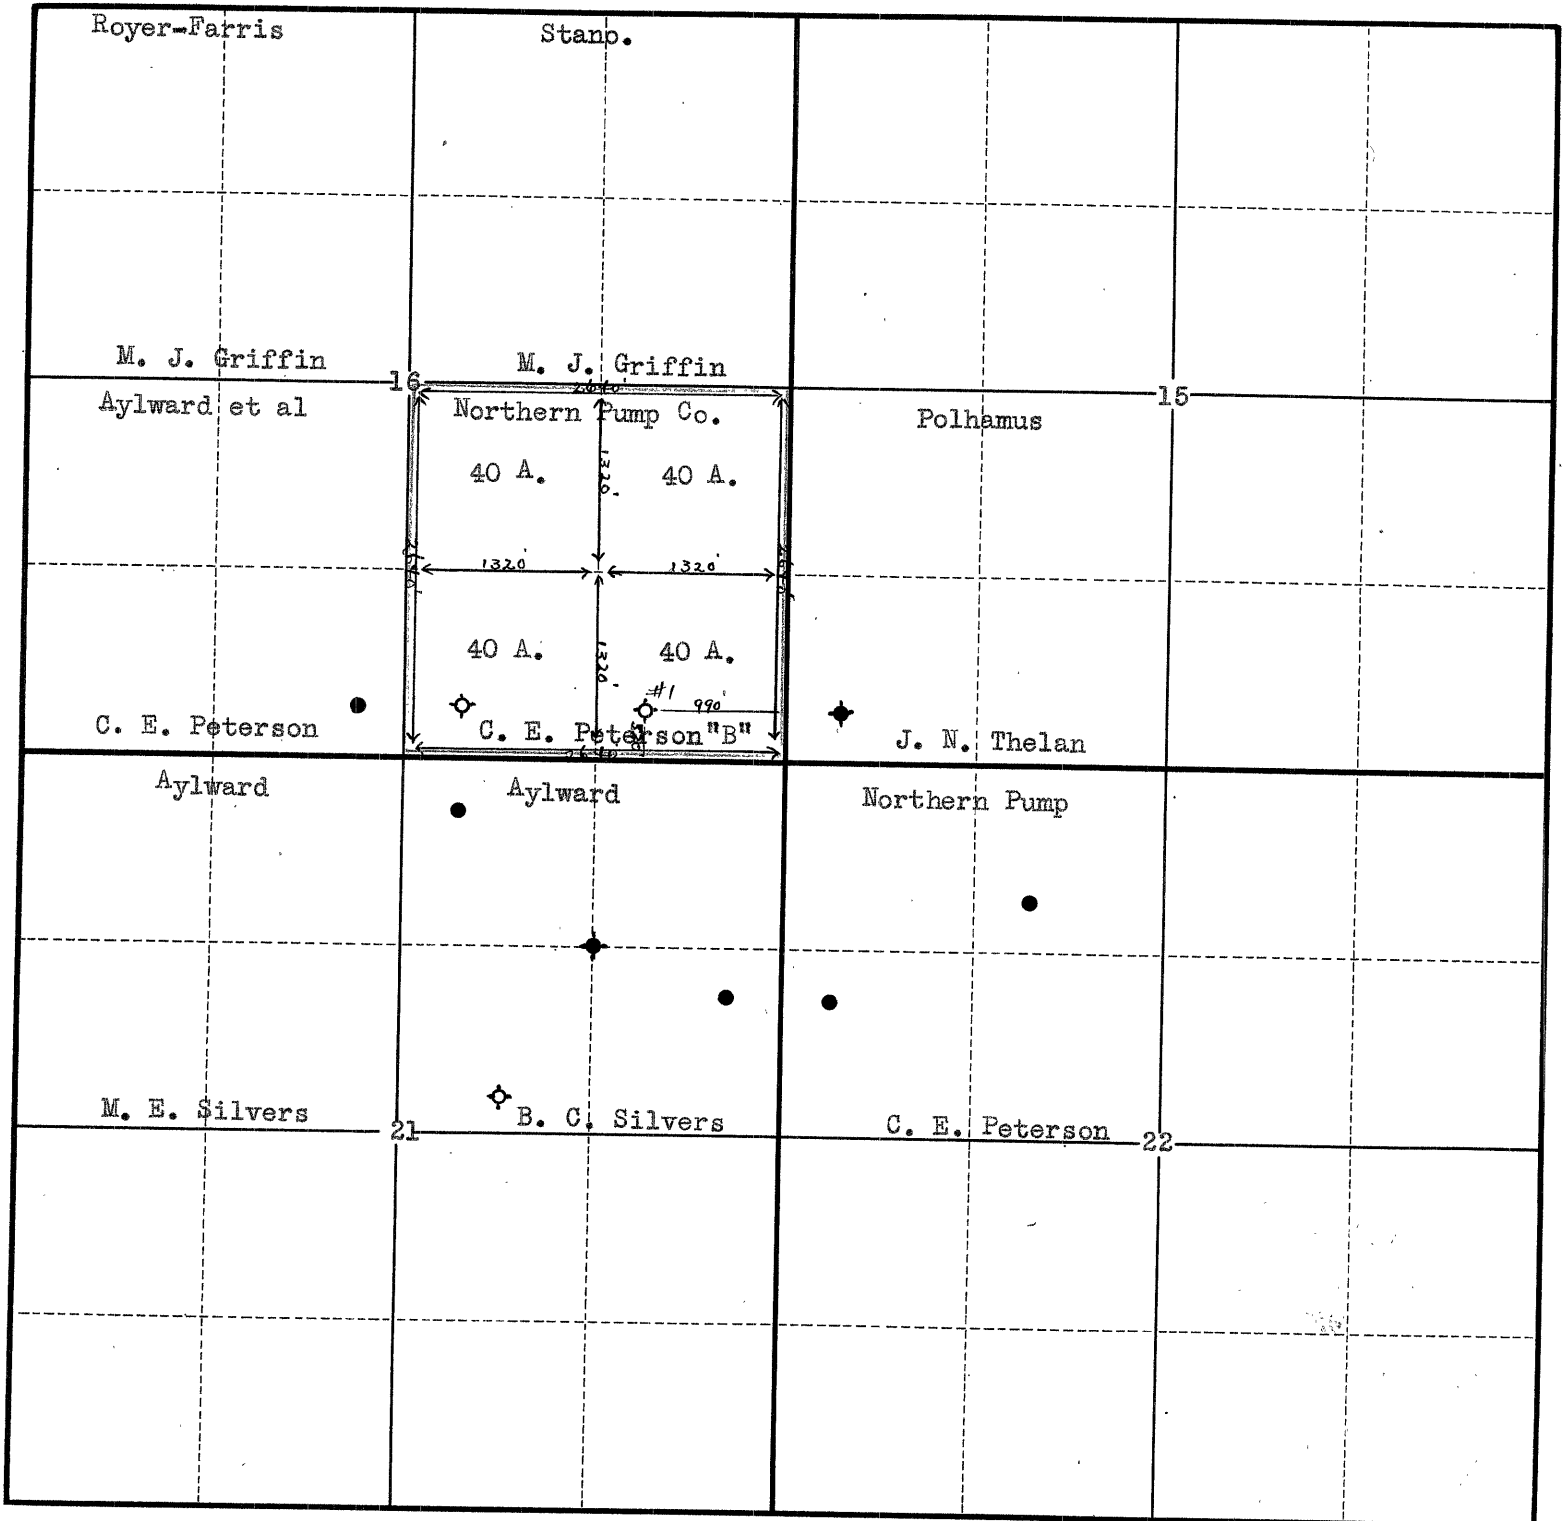

THE KANSAS BLUE PRINT CO.

STATE OF KANSAS,
COUNTY OF ~~SEDGWICK~~ Barton

8-25-48

I, Charles J. Beu
of Northern Pump Company, do hereby certify
that the above locations, feet measurements and areas are true and correct to the best of my knowledge.

Charles J. Beu

Subscribed and sworn to before me this 23rd day of August, 1948.

My commission expires March 10, 1952.

Bessie M. Ganger
NOTARY PUBLIC