

15-163-02577-00-00

STATE OF KANSAS
STATE CORPORATION COMMISSION


WELL PLUGGING RECORD

Give All Information Completely
Make Required Affidavit
Mail or Deliver Report to:
Conservation Division
State Corporation Commission
800 Bittling Building
Wichita, Kansas

OR
FORMATION PLUGGING RECORD

Strike out upper line
when reporting plug-
ging off formations.

NORTH

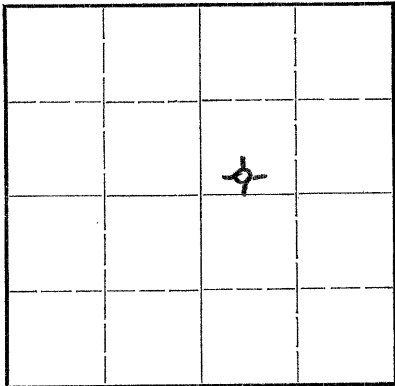

Locate well correctly on above
Section Plat

Rooks County. Sec. 17 Twp. 8 Rge. (E) 19 (W)
Location as "NE $\frac{1}{4}$ NW $\frac{1}{4}$ SW $\frac{1}{4}$ " or footage from lines SE SW OF NE
Lease Owner Royer-Farris Drilling Company
Lease Name Lowry Well No. 1
Office Address 709 Brown Bldg., Wichita 2, Kansas.
Character of Well (completed as Oil, Gas or Dry Hole) Dry Hole
Date well completed March 27, 1947.
Application for plugging filed March 26, 1947.
Application for plugging approved March 26, 1947.
Plugging commenced March 27, 1947.
Plugging completed March 27, 1947.
Reason for abandonment of well or producing formation Dry

If a producing well is abandoned, date of last production Nil 19
Was permission obtained from the Conservation Division or its agents before plugging was com-
menced? Yes

Name of Conservation Agent who supervised plugging of this well Kerr
Producing formation Depth to top Bottom Total Depth of Well 3505 Feet
Show depth and thickness of all water, oil and gas formations.

OIL, GAS OR WATER RECORDS

CASING RECORD

Formation	Content	From	To	Size	Put In	Pulled Out
Surface Soil		0	139	10"		None

Describe in detail the manner in which the well was plugged, indicating where the mud fluid was placed and the method or methods used in introducing it into the hold. If cement or other plugs were used, state the character of same and depth placed, from feet to feet for each plug set.

Started out off bottom pumping extra heavy mud in hole as drill pipe was laid down.
Set bridge plug in 10" conductor pipe at 130 feet and run 30 sax cement on plug, then
run in heavy mud to 20 feet of surface where bridge plug was set and 10 sax of cement
run on this bridge plug.

(If additional description is necessary, use BACK of this sheet)

Correspondence regarding this well should be addressed to Royer-Farris Drilling Company
Address 709 Brown Building, Wichita 2, Kansas.

STATE OF Kansas, COUNTY OF Sedgwick, ss.
L. A. Farris (employee of owner) or (owner or operator) of the above-described well,
being first duly sworn on oath, says: That I have knowledge of the facts, statements, and matters herein contained and the log of the above-
described well as filed and that the same are true and correct. So help me God.

(Signature)

SUBSCRIBED AND SWORN to before me this 31st day of March, 1947.

Effie I. Loute
Notary Public.

My commission expires April 23, 1949.

PLUGGING
FILE SEC 17 T 8 R 19 W
BOOK PAGE 104 LINE 10

8-45-6M

43-47

15-163-02577-00-00

Contractor: Royer-Farris Drilling Co.
Drilling Started: February 28, 1947.
Drilling Completed: March 27, 1947.
Set 1 3/4" of 10" surface pipe
cemented with 90 sacks cement.

0	130	surface soil & shales
130	500	shale
500	810	sand shells iron
810	1195	sand
1195	1252	shale and sand
1252	1419	sand shale & red rock
1419	1460	anhydrite
1460	1540	shale
1540	1805	shale and lime
1805	1855	iron lime shale
1855	1957	lime and shale
1957	2080	salt shale & lime
2080	2222	shale
2222	2655	lime and shale
2655	2895	shale
2895	3196	lime and shale
3196	3272	lime
3272	3326	lime and shale
3326	3441	lime
3441	3465	lime and shale
3465	3505	lime

Measurements are from top of rotary bushing:

Top Anhydrite	1419
Top Hebrer Shale	3162
Top Lansing	3186
Base Lansing	3422
Top Arbuckle	3470
Total Depth	3505

No Shows

Dry and Abandoned

L. A. Farris does hereby swear that he is a partner of the firm, Royer-Farris Drilling Company, who were the drilling contractors on the above described well and that the above log is true and correct to the best of his knowledge and belief.

[Signature]

STATE OF KANSAS)
COUNTY OF SHAWNEE) ss

BE IT REMEMBERED, That on this 31st day of March, A. D. 1947, before me, a Notary Public in and for said County and State, personally appeared L. A. Farris, to me known to be the identical person described in and who executed the within and foregoing instrument and acknowledged to me that he executed the same as his free and voluntary act and deed for the uses and purposes therein set forth.

IN WITNESS WHEREOF, I have hereunto set my official signature and affixed my notarial seal, the day and year first above written.

Effie L. Lote
Notary Public

My Commission expires April 23, 1949.

PLUGGING
FILE SEC 14 T 8 R 19W
BOOK PAGE 104 LINE 10

APR - 5 1947

45-47