

15-163-01080-00-00


All Information Completely  
Required Affidavit  
Be Delivered Report to:  
Conservation Division  
State Corporation Commission  
211 No. Broadway  
Wichita, Kansas

WELL PLUGGING RECORD

Rocks: \_\_\_\_\_ County. Sec. 19 Twp. 8S Rge. 19W (E) \_\_\_\_\_ (W)  
SE SW SE

Location as "NE/CNW%SW%" or footage from lines \_\_\_\_\_  
Lease Owner Dorset Company & D & D Drilling Company, Inc.  
Lease Name Lowry Well No. 11  
Office Address 308 Schweiter Building, Wichita, Kansas  
Character of Well (completed as Oil, Gas or Dry Hole) Dry Hole  
Date well completed 9-20-63 19\_\_\_\_\_  
Application for plugging filed 9-24-63 19\_\_\_\_\_  
Application for plugging approved 9-20-63 19\_\_\_\_\_  
Plugging commenced 9-20-63 19\_\_\_\_\_  
Plugging completed 9-20-63 19\_\_\_\_\_  
Reason for abandonment of well or producing formation Dry Hole

NORTH

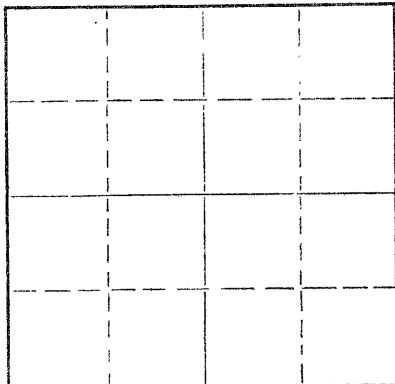

Locate well correctly on above  
Section Plat

If a producing well is abandoned, date of last production \_\_\_\_\_ 19\_\_\_\_\_  
Was permission obtained from the Conservation Division or its agents before plugging was com-  
menced? Yes

Name of Conservation Agent who supervised plugging of this well Eldon Petty, Box 326 Hays, Kansas  
Producing formation \_\_\_\_\_ Depth to top \_\_\_\_\_ Bottom \_\_\_\_\_ Total Depth of Well 3521 Feet  
Show depth and thickness of all water, oil and gas formations.

OIL, GAS OR WATER RECORDS

CASING RECORD

FORMATION	CONTENT	FROM	TO	SIZE	PUT IN	PULLED OUT
Surface hole		0	210'	8 5/8"	9-13-63	

Describe in detail the manner in which the well was plugged, indicating where the mud fluid was placed and the method or methods used  
in introducing it into the hole. If cement or other plugs were used, state the character of same and depth placed, from \_\_\_\_\_ feet to  
\_\_\_\_\_ feet for each plug set.

Filled hole with heavy drilling mud, set plug #1 at 600'  
with 20 sacks cement, plug #2 at 180' with 20 sacks of  
cement, 10 sacks of cement and 1/2 sack hulls

RECEIVED  
STATE CORPORATION COMMISSION

SEP 25 1963

CONSERVATION DIVISION  
Wichita, Kansas

9-25-63

(If additional description is necessary, use BACK of this sheet)

Name of Plugging Contractor D & D Drilling Company, Inc.  
Address 308 Schweiter Building, Wichita, Kansas

STATE OF Kansas, COUNTY OF Sedgwick, ss.  
James R. Daniels (employee of owner) or (owner or operator) of the above-described  
well, being first duly sworn on oath, says: That I have knowledge of the facts, statements, and matters herein contained and the log of the  
above-described well as filed and that the same are true and correct. So help me God.

(Signature) James R. Daniels  
James R. Daniels  
308 Schweiter Bldg., Wichita, Kansas (Address)

SUBSCRIBED AND SWORN TO before me this 24th day of September, 19 63

My commission expires 11-18-66

Colleen Chapple  
Colleen Chapple  
Notary Public.



15-163-01080-00-00

ROTARY DRILLING LOG

OPERATOR: Dorset Company and Comm: 9-12-63  
 D & D Drilling Co., Inc.  
 CONTRACTOR: D & D Drilling Co., Inc. ComP: 9-20-63  
 WELL: Lowry No. 1  
 LOCATION: SE SW SE 19-8S-19W  
 COUNTY: Rooks County, Kansas

FORMATIONS:	DEPTH :	REMARKS:
Surface	180'	Set 6 joints of 8 5/8" surface pipe at 210' cemented with 165 sacks cement. HA-5.
Shale	640'	
Shale & Sand	1140'	
Shale	1150'	
Andy.	1500'	
Shale	1633'	
Shale - Shells	1850'	
Shale - lime	2095'	
Lime & Shale	3223'	
Lime	3457'	
Lime & Shale	3495'	
Lime	3521'	
Rotary Total Depth	3521' D & A	

**RECEIVED**  
STATE CORPORATION COMMISSION

SEP 25 1963

CONSERVATION DIVISION  
Wichita, Kansas

925-63

A F F I D A V I T

State of Kansas )  
 ) SS  
 County of Sedgwick )

James R. Daniels of lawful age, being duly and solemnly sworn on oath says: I am a resident of Wichita, Sedgwick County, Kansas, and I hereby know and on oath state, that the above drilling log covering the Lowry No. 1 located in the SE SW SE of Section 19-8S-19W, Rooks County, Kansas, is true and correct to the best of my knowledge and belief. Further affiant saith not.

D & D Drilling Company, Inc.

By: James R. Daniels  
 James R. Daniels

Subscribed and sworn to before me this 24th day of September, 1963.

My Commission expires 11-18-66

Colleen Chapple  
 Colleen Chapple

