


STATE OF KANSAS
STATE CORPORATION COMMISSION

15-163-00832-00-00

WELL PLUGGING RECORD

Give All Information Completely
Make Required Affidavit
Mail or Deliver Report to:
Conservation Division
State Corporation Commission
211 No. Broadway
Wichita, Kansas

NORTH

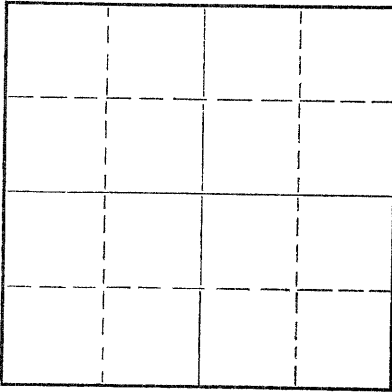

Locate well correctly on above
Section Plat

Rooks County. Sec. 20 Twp. 8 Rge. 19 (E) W (W)
Location as "NE/CNW/SW" or footage from lines SE SE NW
Lease Owner Osage Oil & Gas Co.
Lease Name Bray Well No. 1
Office Address Petroleum Bldg., Wichita, Kansas
Character of Well (completed as Oil, Gas or Dry Hole) Dry hole
Date well completed December 21, 1955
Application for plugging filed December 21, 1955
Application for plugging approved December 21, 1955
Plugging commenced December 21, 1955
Plugging completed December 21, 1955
Reason for abandonment of well or producing formation Not commercial

If a producing well is abandoned, date of last production _____ 19____
Was permission obtained from the Conservation Division or its agents before plugging was commenced? Yes

Name of Conservation Agent who supervised plugging of this well Eldon Petty, Box 326, Hays, Kansas
Producing formation _____ Depth to top _____ Bottom _____ Total Depth of Well 3460 Feet
Show depth and thickness of all water, oil and gas formations.

OIL, GAS OR WATER RECORDS

CASING RECORD

FORMATION	CONTENT	FROM	TO	SIZE	PUT IN	PULLED OUT
	Ran 10 joints of 8-5/8" casing (overall 199.77) set @ 196' w/150 sacks common cement, 300# CC, 2% Gel. P.D. 11:30 p.m. 12-11-55					

Describe in detail the manner in which the well was plugged, indicating where the mud fluid was placed and the method or methods used in introducing it into the hole. If cement or other plugs were used, state the character of same and depth placed, from _____ feet to _____ feet for each plug set.

Mud to 190', set plug and 1/2 sack hulls, 15 sacks cement
mud to 40' set plug and 1/2 sack hulls & 10 sacks cement
to bottom of cellar. P.D. 9:30 a.m. 12-21-55

RECEIVED
1/14/56

(If additional description is necessary, use BACK of this sheet)
Name of Plugging Contractor Garvey Drilling Company
Address 311 East Third, Wichita, Kansas

STATE OF KANSAS, COUNTY OF SEDGWICK, ss.
B. V. Bock (employee of owner) or (owner or operator) of the above-described well, being first duly sworn on oath, says: That I have knowledge of the facts, statements, and matters herein contained and the log of the above-described well as filed and that the same are true and correct. So help me God.
OSAGE OIL & GAS CO., INC.
(Signature) By Maurine L. Shiever

SUBSCRIBED AND SWORN TO before me this 13th day of January, 1956
My commission expires October 25, 1956
Maurine L. Shiever
Maurine L. Shiever
Notary Public.

PLUGGING
FILE SEC 20 T 8 R 19W
BOOK PAGE 27 LINE 38

WELL LOG 15-163-00832-00-00

COMPANY OSAGE OIL & GAS CO.

SEC. 20 T. 8S R. 19W

FARM Bray NO. 1

LOC. SE SE NW

TOTAL DEPTH 3460'

COUNTY Rocks

COMM. December 11, 1955 COMP. December 21, 1955

CONTRACTOR GARVEY DRILLING COMPANY

CASING 8-5/8" @ 196' w/150 sacks


ELEVATION

PRODUCTION

FIGURES INDICATE BOTTOM OF FORMATIONS

85	Clay & Rock
865	Shale & Shell
1375	Sand & Shale
1389	Shale & Shells
1430	Anhydrite
1840	Shale & Shell
2290	Shale & Lime
2415	Lime
2725	Lime & Shale
2800	Lime
2920	Lime & Shale
2930	Shale
3097	Lime
3150	Lime & Shale
3386	Lime
3435	Lime & Shale
3460	Lime
3460	T. D.

1/14/52

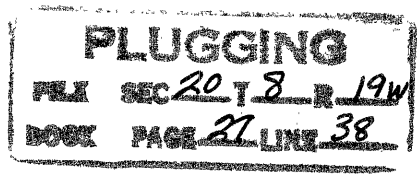

State of KANSAS }
 County of SEDGWICK } SS :

I, Robert F. White of GARVEY DRILLING COMPANY

upon oath state that the above and foregoing is a true and correct copy of the log of the #1 Bray well

Robert F. White

Subscribed and sworn to before me this 29th day of December 19 55

My Commission Expires: August 8, 1959

Gloria M. ...
 NOTARY PUBLIC