

STATE OF KANSAS
STATE CORPORATION COMMISSION

15-163 20991-0000
WELL PLUGGING RECORD

Give All Information Completely
Make Required Affidavit
Mail or Deliver Report to
Conservation Division,
State Corporation Comm.,
245 North Water
Wichita, KS 67202

Rooks County, Sec. 20 Twp. 18S Rge. 19 E/W
Location as "NE/CNW/SW" or footage from lines
C W/2 NE SE

Lease Owner Liberty Enterprises, Inc.
Lease Name Veverka Well No. #1

Office Address 308 West Mill Plainville, Ks. 67663
Character of Well (Completed as Oil, Gas or Dry Hole)


Dry Hole

Date Well completed April 6, 1980
Application for plugging filed April 6, 1980
Application for plugging approved April 6, 1980
Plugging commenced April 6, 10:30 A.M. 1980
Plugging completed April 6, 12:00 P.M. 1980

Reason for abandonment of well or producing formation
No Commercial Production

If a producing well is abandoned, date of last production
19

Was permission obtained from the Conservation Division or
its agents before plugging was commenced? yes

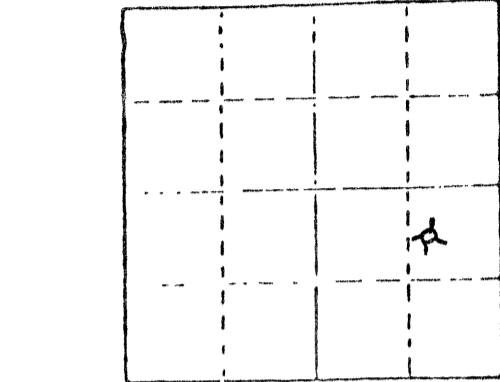

Locate well correctly on above
Verbois Plat

Name of Conservation Agent who supervised plugging of this well Marion Schmidt
Producing formation Depth to top Bottom Total Depth of Well

Show depth and thickness of all water, oil and gas formations.

OIL, GAS OR WATER RECORDS

CASING RECORD

LOCATION	CONTENT	FROM	TO	SIZE	PUT IN	PULLED OUT
Surface Casing	common	0	216.04'	8 5/8"	216.04'	0

Describe in detail the manner in which the well was plugged, indicating where the mud plug was placed and the method or methods used in introducing it into the hold. If cement or other plugs were used, state the character of same and depth placed, from feet to feet for each plug set.

Plug #1 @ 720' with 60 sxs
Plug #3 @ 210' with 30 sxs
Plug #4 @ 40' with 10 sxs
5 sxs in rathole
50-50 poz 6% gel

4/10/80

(If additional description is necessary, use BACK of this sheet)

Name of Plugging Contractor Pioneer Drilling Company, Inc.
308 West Mill Plainville, Kansas 67663

STATE OF Kansas COUNTY OF Rooks, ss.
Charles G. Comeau (employee of owner) or (owner or operator)

of the above-described well, being first duly sworn on oath, says: That I have knowledge of the facts, statements, and matters herein contained and the log of the above-described well as filed and that the same are true and correct. So help me God.


(Signature)

308 West Mill Plainville, Ks. 67663
(Address)

SUBSCRIBED AND SWORN TO before me this 9th day of April, 1980

Notary Public.

My commission expires

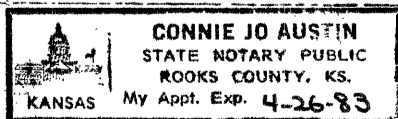

WELL LOG

15-163-20991-00-00

OPERATOR: Liberty Enterprises, Inc.

WELL NAME: Veverka #1 LOCATION: C W/2 NE SE 20-8S-19W

COUNTY: Rooks STATE: Kansas

WELL COMMENCED: March 26, 1980 WELL COMPLETED: April 6, 1980

ELEVATION: 2005' K.B. TOTAL DEPTH: 3500'

PRODUCTION: D & A RIG NO: #2

CASING - 8-5/8": 216.04' of 28# used cemented with 140 sxs common 2% gel 3% cc cement circ plugdown @ 11:00 P.M. 5 Jts.
5-1/2": none

ALL MEASUREMENTS TAKEN FROM THE TOP OF ROTARY BUSHING:

FROM	TO	FORMATION	DEVIATION FROM VERTICAL	REMARKS:
0'	222'		222' - 1 degree	
222'	880'	sand and shale		
880'	1638'	sand and shale		
1638'	1900'	shale	1720' - 3/4 degree	
1900'	2200'	sand and shale		
2200'	2384'	shale	2384' - 3/4 degree	
2384'	2570'	shale		
2570'	2700'	shale and lime		
2700'	2908'	shale and lime		
2908'	3040'	shale and lime		
3040'	3140'	shale and lime		
3140'	3188'	lime and shale		
3188'	3203'	shale and lime		
3203'	3250'			
3250'	3308'	lime and shale		
3308'	3375'	lime and shale		
3375'	3446'	lime and shale		
3446'	3456'			
3456'	3500'	lime and shale		
3500'	RTD			

RECEIVED
STATE CORPORATION COMMISSION

APR 10 1980

CONSERVATION DIVISION
Wichita, Kansas

4/10/80

STATE OF KANSAS
COUNTY OF

The undersigned hereby certifies that to the best of his knowledge and belief, the above facts are true and correct

PIONEER DRILLING CO., INC.
By [Signature]

SUBSCRIBED AND SWORN TO, BEFORE ME, This 9th day of April, 1980.

[Signature]
- NOTARY PUBLIC

